

MAY 24 2000

LIBER 20560 198

SECTION

LAND CORNER RECORDATION CERTIFICATE
Filing Requirement of Act 74, Mich. P.A. 1970

345421

For corners in

Form with fields for Oakland (County), Located In: Highland Township, Corner Code #, and survey types: 1. Public Land Survey, 2. Property Controlling in Section, 3. Miscellaneous Property in Sec.


LIBER 20560 PAGE 498
\$9.00 NISC RECORDING
\$2.00 REMONUMENTATION
09/20/1999 08:43:18 A.M. RECEIPT# 79775
PAID RECORDED - OAKLAND COUNTY
G. WILLIAM CADDELL, CLERK/REGISTER OF DEEDS

Compliance with ACT 345, P.A. 1990

APPROVED ON: 8-9-99 J/L
OAKLAND COUNTY REMONUMENTATION PEER GROUP COMMITTEE
Register of Deeds Stamp & File Number

4. Lot No. Recorded Plat
5. Private Claims

I, Huston K. Kennedy, in a field survey on April 15, 1999 do hereby state that under requirements of P.A. 74, Michigan P.A. of 1970, the corner points mentioned in lines 1 and 2 above were in conformance with regulations and rules therefore as required in the current manual of survey instructions of the United States Department of the Interior, Bureau of Land Management or by a decree of a Court of Law and/or that the corner points mentioned in lines 3, 4 and 5 above were in conformance with the rules of the Michigan Board of Land Surveyors or by a Decree of a Court of Law; established, re-established, monumented, recovered, found as expressed below:

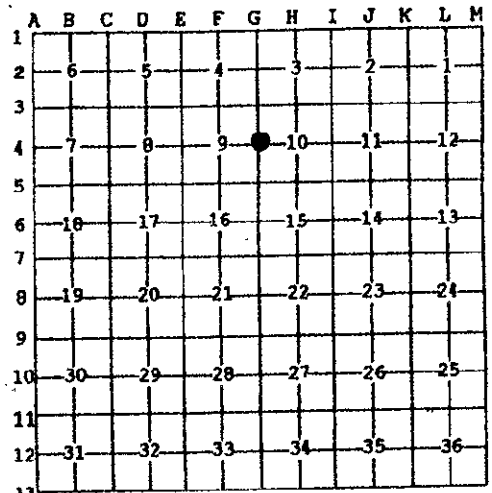

NOTE: Not more than 2 corners, all in the same town and range, may be recorded on this certificate.

- A. Description of original monument and accessories and/or subsequent restoration:
1817-GLO Wampler, D.S.; Set Post 18" White Oak N35°E 53 Links; 15" Black Oak S20°W 70 Links
1.) 1972-Adams, PS #17608; LCRC L.5869, Pgs.324 & 325 - Fnd a 3/4" Pipe
2.) 1977-Albright, PS #10057; LCRC L.7077, Pg.259 - Fnd a 1" Pipe
3.) 1991-Thompson, PS #23828; LCRC L.11985, Pg. 584 - Fnd 1/2" Iron
4.) 1995-Thompson, PS #23828; LCRC L.15655, PG.261 - Fnd a 1/2" Iron, used same wit as 1991 LCRC
5.) 1971-Finney & Kostecke, Inc.; Unrecorded Survey - Object found not stated, no witnesses

(Con't on back side)

- B. Description of corner evidence found and/or method applied in restoring or reestablishing corner:
1999-Kennedy Surveying, Inc. - Kennedy, PS #17623 - Fnd a 1/2" Iron Rod located in a old fence line extending to the East West, with a tree row extending to the North.

Witnesses from LCRC #1, 3 & Unrecorded Survey #6 were used to recover and verify the location of the found 1/2" Iron Rod.

I accepted the found 1/2" Iron Rod as the best evidence of the original corner position.


FIELD MEASUREMENTS BETWEEN

G-4 to G-3

GLO = 40 chains or 2640.00 Ft.
Sidwell W 1/2 of NW 1/4 Sec 10 (11-10A) = 2686.02 Ft.
Sidwell E 1/2 of NE 1/4 of Sec 9 (11-9D) = 2686.21 Ft.
Unrecorded Survey by Christopher W. Newman, PS #24607 dated 4/24/92 = 2685.24 Ft (CAL)
2685.01 Ft. (GPS-MEA)

G-4 to G-5

GLO = 40 chains or 2640.00 Ft.
Sidwell W 1/2 of SW 1/4 Sec 10 (11-10E) = 2685.91 Ft.
"HIGHLAND HEIGHTS" (Sec 9) = 2608.90 Ft. (CAL)
"DODGE FARMS" (Sec 10) = 2608.50 Ft. (CAL)
Unrecorded Survey by Thompson, PS #23828 dated 3/15/95 = 2631.89 Ft. (CAL)
2631.50 Ft. (GPS-MEA)

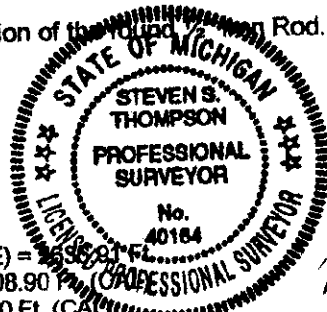

- C. Description of monument for corner and accessories established to perpetuate locating the position of the corner:
G-4 I replaced the found 1/2" Iron Rod with 4" diameter Concrete Monument 36" long with a 1/2" Iron Rod w/ 2" diameter bra cap stamped Oakland County Remonumentation, PS #17623
N02°W 15.75' Set Mag Nail & Remon Washer East face 18" Cherry
N30°W 26.20' Set Mag Nail & Remon Washer NW face 10" Cherry
N67°W 36.75' Set Mag Nail & Remon Washer North face 23" Oak
S52°W 9.75' Set Mag Nail & Remon Washer NW face 11" Hickory

The selected location is accepted by me and is generally accepted by Professional Surveyors as the best available evidence the position of the original corner.

Signed by [Signature]
Surveyor's Michigan License No. 17623

Date 8-5-99