

SURVEY & REMONUMENTATION

MAY 24 2000

LIBER 19872 PC098

SECTION

LAND CORNER RELOCATION CERTIFICATE

139686

or corners in

Oakland (County)

Located In: Highland Township Corner Code #

LIBER 19872 PAGE 98 \$9.00 MISC RECORDING \$2.00 REMONUMENTATION 04/22/1999 07:54:41 A.M. RECEIPT# 22152 PAID RECORDED - OAKLAND COUNTY G. WILLIAM CADDELL, CLERK/REGISTER OF DEEDS

Table with columns for Survey Type (Public Land Survey, Property Controlling in Section, Miscellaneous Property in Sec.), Corner Code (T3N, R7E, M-2), and checkboxes for S/T.

Compliance with ACT 345, P.A. 1990 APPROVED ON: 4-15-99 JS OAKLAND COUNTY REMONUMENTATION PEER GROUP COMMITTEE

Register of Deeds Stamp & File Number

12x12 grid with columns A-L and rows 1-12, containing numbers 1-36.

Huston K. Kennedy, in a field survey on March 1, 1999 do hereby state that under requirements of P.A. 74, Michigan P.A. of 1970, the corner points mentioned in lines 1 and 2 above were in conformance with regulations and rules therefore as required in the current manual of survey instructions of the United States Department of the Interior, Bureau of Land Management or by a decree of a Court of Law and/or that the corner points mentioned in lines 3, 4 and 5 above were in conformance with the rules of the Michigan Board of Land Surveyors or by a Decree of a Court of Law, established, re-established, monumented, discovered, found as expressed below:

NOTE: Not more than 2 corners, all in the same town and range, may be recorded on this certificate.

- 1. Description of original monument and accessories and/or subsequent restoration: 1815-1817-GLO Holmes, D.S.; A post was set, no witnesses 1.) 1979-King, PS #25852; LCRC L.7542, Pg.805 - Fnd 1/2" Pipe 2.) 1991-Thompson, PS #23828; LCRC L.12203, Pg.755 - Fnd a 1/2" Iron Rod in a Monument Box 3.) 1997-Kovas, PS #33138; LCRC for (A-2 White Lake Twp.) L.17882, Pg.455 - Fnd a 1/2" Re-rod in a Monument Box 4.) 1988-Thompson, PS #23828; Unrecorded Survey - Fnd 1/2" Iron Bar in a Monument Box, used same wit as 1991 LCRC 5.) Hahn, PS ?; Unrecorded Survey - Object found not stated, no witnesses


- 3. Description of corner evidence found and/or method applied in restoring or reestablishing corner: 1999-Kennedy Surveying, Inc. - Kennedy, PS #17623 - Fnd a 5/8" Iron Rod with 2" diameter brass cap stamped Oakland County Remonumentation PS #33138 in a Monument Box located in the existing centerline of Eagle Road extending to the North & South, which has a bituminous surface to the North and a gravel surface to the South, in the existing centerline of White Lake Road extending to the East & West, which has a bituminous surface to the West and a gravel surface to the East. This corner is being accepted and used as a common corner with the East 1/4 corner of Section 6, T3N, R8E, White Lake Township (A-2).

Witnesses from dLCRC #1, 2 & 3 were used to recover and verify the location of the found a 5/8" Iron Rod with 2" diameter brass cap stamped Oakland County Remonumentation PS #33138 in a Monument Box.

I accepted the found 5/8" Iron Rod with 2" diameter brass cap stamped Oakland County Remonumentation PS #33138 in a Monument Box as the best evidence of the original corner position.

Field measurements see back side of LCRC

- C. Description of monument for corner and accessories established to perpetuate locating the position of the corner: M-2 I accepted the found 5/8" Iron Rod with 2" diameter brass cap stamped Oakland County Remonumentation PS #33138 in a existing Monument Box S41°W 105.11' Fnd Mag Nail & Remon Washer stamped Oakland County Remon PS #33138 NW face S85°W 151.66' Fnd Mag Nail & Remon Washer stamped Oakland County Remon PS #33138 North face N77°E 216.06' Fnd Mag Nail & Remon Washer stamped Oakland County Remon PS #33138 South face N40°W 62.92' Fnd Mag Nail & Remon Washer stamped Oakland County Remon PS #33138 NE face Power

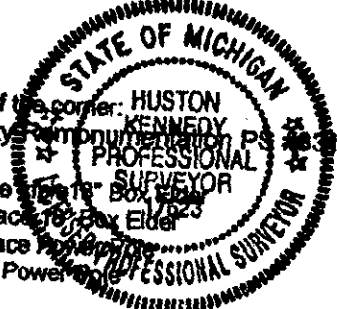

The selected location is accepted by me and is generally accepted by Professional Surveyors as the best available evidence of the position of the original corner.

Signed by: [Signature] Surveyor's Michigan License No. 17623

Date 4-16-99