
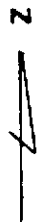


OAKLAND  
COUNTY


White LAKE  
TOWNSHIP

I-3

Section 2  
T. 3 N - R. 8 E

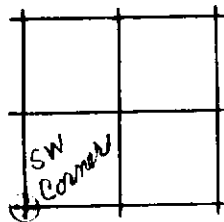

Remarks

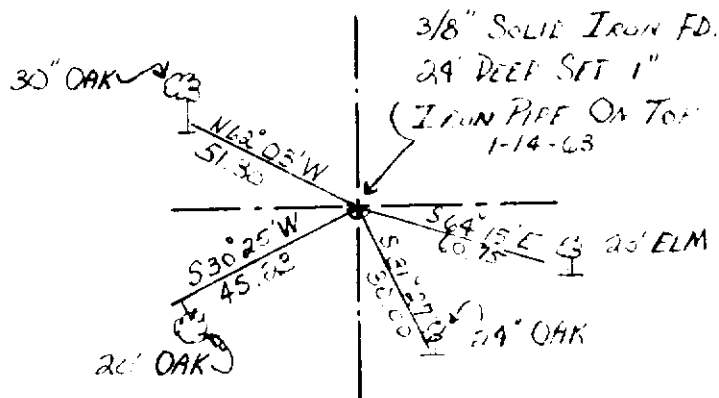

DATE 1-14-63 BY \_\_\_\_\_