


Form 914.

T. 3 N. R. 8 E. Mer.

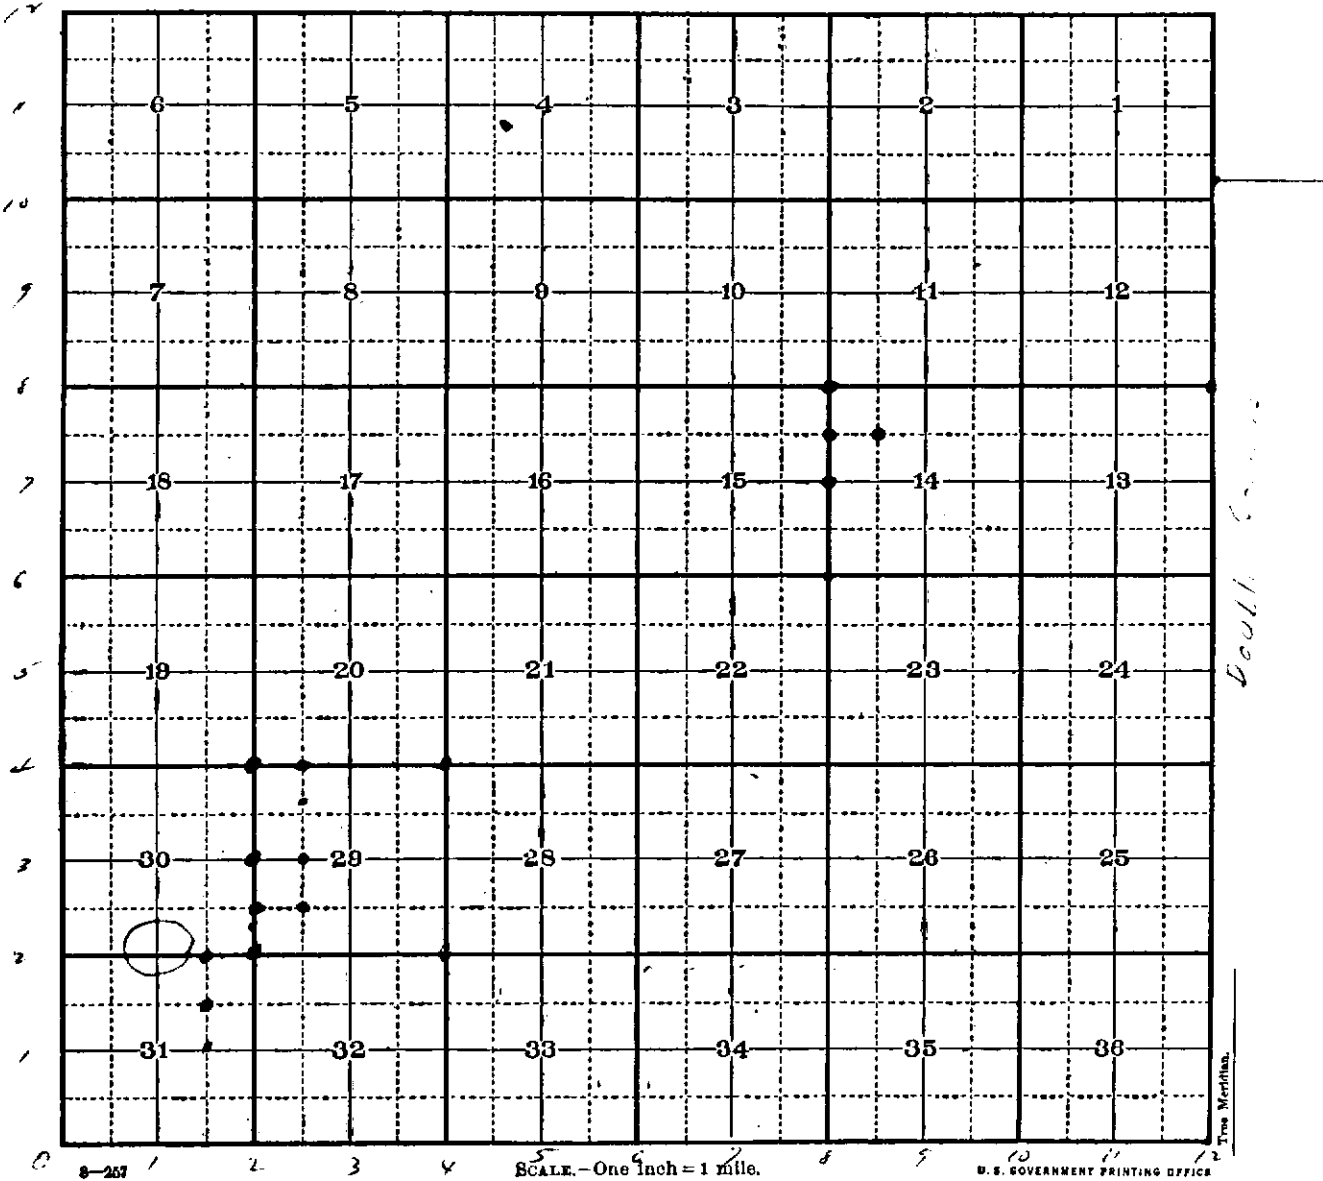

Doubt Contain

True Meridian