

MICHIGAN
DEPARTMENT OF CONSERVATION
FORESTRY DIVISION

(6)

LAND CORNER RECORD

T. 3 N.R. 8E


Oakland COUNTY

DESCRIPTION OF CORNER 1" Iron

CORNER MONUMENT Sections 9-10-15-16

DATE MONUMENT PLACED AND WITNESSED 4-24-62

WITNESSES TO CORNER..... N 43°W 37.0ft twin 15" Elm

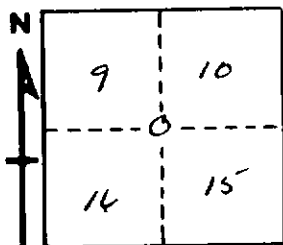

CIRCLE CORNER REGISTERED


N 26°E 49.75ft twin 20" B. Oak

S 64°E 50.0ft W. Oak 40"

AND S 65°W 36.1ft 18" B. Oak

DESCRIPTION IN DETAIL AS TO HOW CORNER WAS LOCATED AND IDENTIFIED ~~RECORDED~~.

Corner Recovered - witnessed prior to this date.

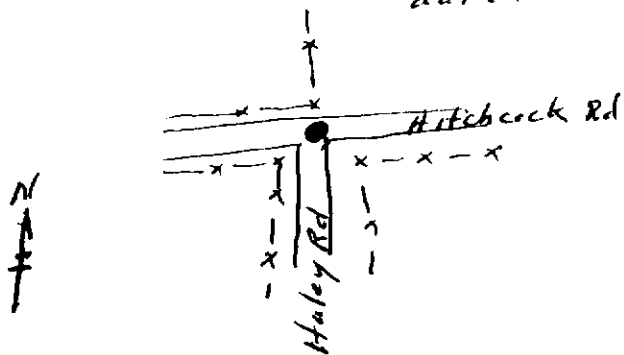

SURVEYOR'S SEAL

SIGNED *Dwight J. [Signature]* DATE 4-26-62
REGISTERED LAND SURVEYOR