

STATE OF MICHIGAN
DEPARTMENT
OF
NATURAL RESOURCES

LAND CORNER RECORD


OAKLAND COUNTY
T 3N R 8E

DESCRIPTION OF CORNER 1" IRON

CORNER MONUMENT SECTIONS 9, 10, 15 & 16

DATE MONUMENT ~~RECORDED~~ WITNESSED 4/24/62

WITNESSES TO CORNER..... N 43° W 37.0' TWIN 18" ELM

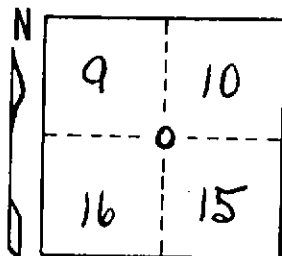


N 26° E 49.75' TWIN 20" B. OAK

S 64° E 50.0' 40" W. OAK

AND
S 65° W 36.1 FT 18" B. OAK

CIRCLE CORNER REGISTERED

DESCRIPTION IN DETAIL AS TO HOW CORNER WAS LOCATED AND IDENTIFIED OR RESTORED.

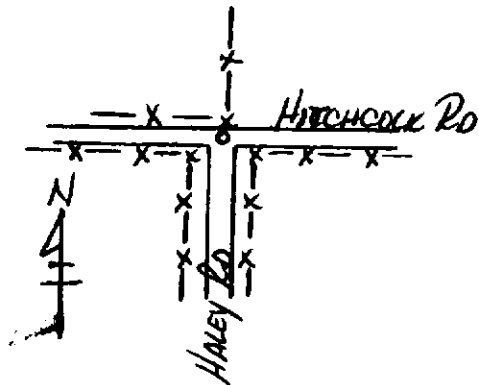

CORNER RECOVERED - WITNESSED
PRIOR TO THIS DATE.

SURVEYOR'S SEAL

DISTRIBUTION:

SIGNED

[Signature]
REGISTERED LAND SURVEYOR

DATE

4/26/62

County Courthouse
Area Forester (Regions I & II)
District or Region Surveyor
Forestry Div., Lansing