


Oakland
COUNTY


White Lake
TOWNSHIP

I-2

Section 2
T. 3 N-R. 8 E

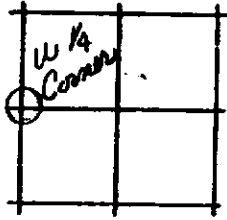

Remarks

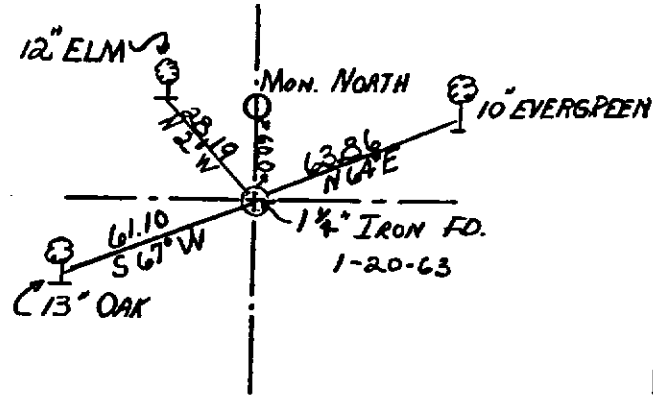


DATE 1-20-63 BY

OAKLAND
COUNTY


White Lake
TOWNSHIP

I-3

Section 2
T. 3 N-R. 8 E

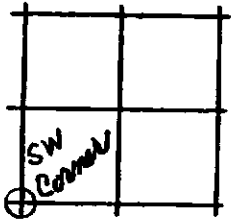

Remarks

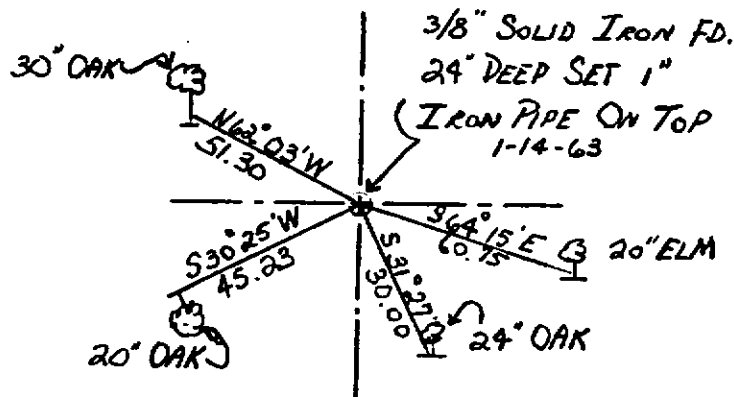


DATE 1-14-63 BY

OAKLAND
COUNTY


White Lake
TOWNSHIP

J-2

Section 2
T. 3 N-R. 8 E

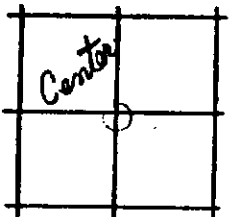

Remarks

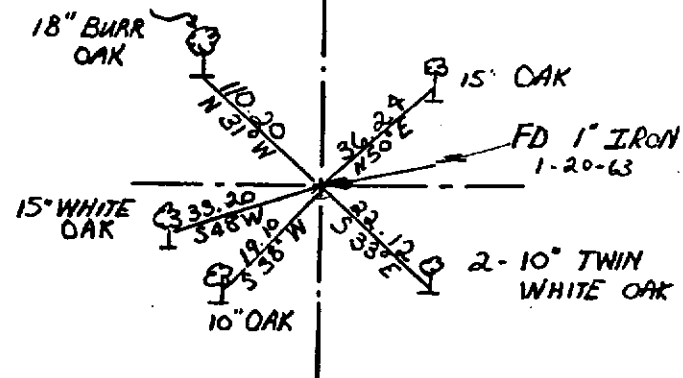

DATE 1-20-63 BY