

**SURVEY & REMONUMENTATION**

MAY - 1 1995

LIBER 15288 PG 553

Mar 1 095 040463  
OK - T. SMITH

**LAND CORNER RECORDATION CERTIFICATE**

Filing Requirement of Act 74, Mich. P.A. 1970

For corners in **COMMISSION**

OAKLAND  
(County)

Located In: **WATERFORD** Corner Code #:

7.00 MISC RECORDING CHG - IN HOUSE  
\$ 2.00 REMON CHG - IN HOUSE  
10 MAR 95 4:13 P.M. RECEIPT# 1788  
PAID RECORDED - OAKLAND COUNTY  
LYNN D. ALLEN, CLERK/REGISTER OF DEEDS

Compliance with  
ACT 345, P.A. 1990

APPROVED ON: 12-30-94  
OAKLAND COUNTY REMONUMENTATION  
PEER GROUP COMMITTEE

Register of Deeds Stamp & File Number

- |                                    |             |     |
|------------------------------------|-------------|-----|
| 1. Public Land Survey              | T 3 N R 9 E | A-2 |
|                                    | T R         |     |
|                                    | T R         |     |
|                                    | T R         |     |
| 2. Property Controlling in Section | S T R       |     |
|                                    | S T R       |     |
| 3. Miscellaneous Property in Sec.  | S T R       |     |
|                                    | S T R       |     |

4. Lot No. \_\_\_\_\_, Recorded Plat \_\_\_\_\_  
5. Private Claims \_\_\_\_\_

I, THOMAS M. SMITH, in a field survey on DECEMBER 1, 19 94, do hereby certify that under requirements of P.A. 74, Michigan P.A. of 1970, the corner points mentioned in lines 1 and 2 above were in conformance with regulations and rules therefore as required in the current manual of survey instructions of the United States Department of the Interior, Bureau of Land Management or by a decree of a Court of Law and/or that the corner points mentioned in lines 3, 4 and 5 above were in conformance with the rules of the Michigan Board of Land Surveyors or by a Decree of a Court of Law; established, re-established, monumented, re-monumented, recovered, found as expressed below:

**NOTE: Not more than 4 corners, all in the same town and range, may be recorded on this certificate.**


A	B	C	D	E	F	G	H	I	J	K	L	M
2	6	5	4	3	2	1						
3												
4	7	8	9	10	11	12						
5												
6	18	17	16	15	14	13						
7												
8	19	20	21	22	23	24						
9												
10	30	29	28	27	26	25						
11												
12	31	32	33	34	35	36						
13												

**A. Description of original monument and accessories and/or subsequent restoration:**

POST, G.L.O. 1817	1" PIPE, MOUNTAIN VIEW COUNTRY CLUB SUBDIVISION, 1925	CONCRETE MONUMENT, L.C.R.C BY G. STONEROCK, LIBER 6748, PG. 611 1976
----------------------	--	--

**B. Description of corner evidence found and/or method applied in restoring or reestablishing corner:**

FOUND A CONCRETE MONUMENT, 4" DIAMETER CYLINDER WITH A 1/2" RE-ROD. FOUND ALL WITNESSES AS CONTAINED IN LAND CORNER CERTIFICATE RECORDED IN LIBER 6748, PAGE 611 TO VERIFY MONUMENT. MEASUREMENTS SOUTH TO VARIOUS LOT CORNERS VERIFY THE MONUMENT AS THE WEST 1/4 CORNER

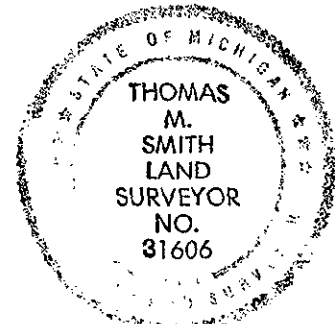

**C. Description of monument for corner and accessories established to perpetuate locating the position of the corner:**

A-2: FOUND A CONCRETE MONUMENT. I PLACED THE OAKLAND CO. BRASS TAG ON EXISTING MONUMENT.  
S 30 E 12.65' to remon. tag West Side of 12" Oak  
N 70 E 37.39' to remon. tag N.W. side of 10" Maple  
N 80 W, 46.27' to remon. tag W. Side 9" Maple (twin)  
N 15 W, 41.70 to remon. tag E. Side 6" Maple

7.00  
2.00

The selected position is accepted by me and is generally accepted by Professional Surveyors as the best available evidence of the position of the corner.

Signed by [Signature]

Date DECEMBER 19, 1994

Surveyor's Michigan License No. 31606