

**SURVEY &
REMONUMENTATION**

LIBER **15288** PG **552**

MAR 10 95 04 04 62

MAY - 1 1995

T. SMITH

LAND CORNER RECORDATION CERTIFICATE

Filing Requirement of Act 74, Mich. P.A. 1970

For corners in **COMMISSION**

OAKLAND (County) Located In: WATERFORD Corner Code #

1. Public Land Survey	T <u>3</u> N R <u>9</u> E	<u>A-7</u>
	T _____ R _____	_____
	T _____ R _____	_____
	T _____ R _____	_____
2. Property Controlling in Section	S _____ T _____ R _____	_____
	S _____ T _____ R _____	_____
3. Miscellaneous Property in Sec.	S _____ T _____ R _____	_____
	S _____ T _____ R _____	_____

7.00 MISC RECORDING CHG - IN HOUSE
\$ 2.00 REMON CHG - IN HOUSE
10 MAR 95 4:12 P.M. RECEIPT# 1788
PAID RECORDED - OAKLAND COUNTY
LYNN D. ALLEN, CLERK/REGISTER OF DEEDS

Compliance with ACT 345, P.A. 1990

APPROVED ON: 12-30-94
OAKLAND COUNTY REMONUMENTATION
PEER GROUP COMMITTEE

Register of Deeds Stamp & File Number

4. Lot No. _____, Recorded Plat _____
5. Private Claims _____

I, THOMAS M. SMITH, in a field survey on DECEMBER 1, 19 94, do hereby certify that under requirements of P.A. 74, Michigan P.A. of 1970, the corner points mentioned in lines 1 and 2 above were in conformance with regulations and rules therefore as required in the current manual of survey instructions of the United States Department of the Interior, Bureau of Land Management or by a decree of a Court of Law and/or that the corner points mentioned in lines 3, 4 and 5 above were in conformance with the rules of the Michigan Board of Land Surveyors or by a Decree of a Court of Law; established, re-established, monumented, re-monumented, recovered, found as expressed below:

A	B	C	D	E	F	G	H	I	J	K	L	M
2	6	5	4	3	2	1						
3												
4	7	8	9	10	11	12						
5												
6	18	17	16	15	14	13						
7												
8	19	20	21	22	23	24						
9												
10	30	29	28	27	26	25						
11												
12	31	32	33	34	35	36						
13												


NOTE: Not more than 4 corners, all in the same town and range, may be recorded on this certificate.

A. Description of original monument and accessories and/or subsequent restoration:

POST, G.L.O. 1817	ANGLE IRON OAKLAND COUNTY ROAD COMMISSION 1963	ANGLE IRON L.C.R.C., L. 6209, PG. 320 N.C. JONES, 1973
----------------------	--	--

B. Description of corner evidence found and/or method applied in restoring or reestablishing corner:

I FOUND A ANGLE IRON AT THE S.E. BASE OF A 60" WILLOW TREE, JUST EAST OF A PARKING LOT TO WHITE LAKE OAKS GOLF COURSE. WITNESSES REMAINED FROM N.C. JONES L.C.R.C. AND WERE USED TO VERIFY CORNER POSITION. TWO OF THE ROAD COMMISSION WITNESSES WERE TO THE SAME TREE AS N.C. JONES L.C.R.C. BUT NO NAILS WERE FOUND FOR THE ROAD COMMISSION TIES. A DISTANCE WAS MEASURED EAST TO THE SOUTH 1/4 CORNER OF SECTION 18 OF 2261.03 COMPARED TO THE PLATTED DISTANCE OF 2261.39 FEET AS SHOWN ON THE SUPERVISOR'S PLAT NO. 27(1944) A DISTANCE OF 2674.13 FEET WAS MEASURED SOUTH TO THE WEST 1/4 CORNER COMPARED TO 2674.10 MEASURED BY J. JEWELL (1945).

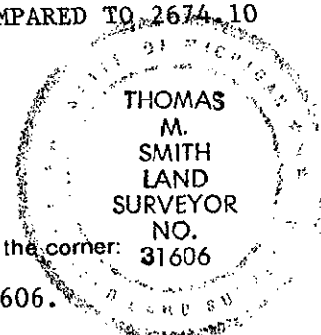

C. Description of monument for corner and accessories established to perpetuate locating the position of the corner:

I REPLACED THE ANGLE IRON WITH A CONCRETE MONUMENT WITH A BRASS TAG #31606.
S 85 E, 25.20 to remon tag S. Side of 6" Oak
N 60 E, 32.97 to remon. tag S. Side of 12" Oak
N 60 W, 43.02 to remon. tag S.E. Side 10" Oak
South, 214.45 feet to a concrete monument w/brass tag No. 31606(M-7, White Lake Twp.)

The Selected location is accepted by me and is generally accepted by Professional Surveyors as the best available evidence of the position of the original corner.

Signed by [Signature] Date DECEMBER 19, 1994
Surveyor's Michigan License No. 31606