

**SURVEY &
REMONUMENTATION**

LIBER 15288 PG 551

MAR 10 95 040461

OK - T. SMITH

MAY - 1 1995

LAND CORNER RECORDATION CERTIFICATE

Filing Requirement of Act 74, Mich. P.A. 1970 7.00 MISC RECORDING CHG - IN HOUSE

COMMISSION

For corners in

OAKLAND

(County)

Located In: WATERFORD

Corner Code ##

\$ 2.00 REMON CHG - IN HOUSE
10 MAR 95 4:12 P.M. RECEIPT# 178R
PAID RECORDED - OAKLAND COUNTY
LYNN D. ALLEN, CLERK/REGISTER OF DEEDS

Compliance with
ACT 345, P.A. 1990

APPROVED ON: 12-30-94
OAKLAND COUNTY REMONUMENTATION
PEER GROUP COMMITTEE

Register of Deeds Stamp & File Number

- | | | | | | | | |
|------------------------------------|---|----------|---|---|----------|---|-----|
| 1. Public Land Survey | T | <u>3</u> | N | R | <u>9</u> | E | A-8 |
| | T | | R | | | | |
| | T | | R | | | | |
| | T | | R | | | | |
| 2. Property Controlling in Section | S | | T | | R | | |
| | S | | T | | R | | |
| 3. Miscellaneous Property in Sec. | S | | T | | R | | |
| | S | | T | | R | | |

4. Lot No. _____, Recorded Plat _____
5. Private Claims _____

I, THOMAS M. SMITH, in a field survey on DECEMBER 1, 19 94, do hereby certify that under requirements of P.A. 74, Michigan P.A. of 1970, the corner points mentioned in lines 1 and 2 above were in conformance with regulations and rules therefore as required in the current manual of survey instructions of the United States Department of the Interior, Bureau of Land Management or by a decree of a Court of Law and/or that the corner points mentioned in lines 3, 4 and 5 above were in conformance with the rules of the Michigan Board of Land Surveyors or by a Decree of a Court of Law; established, re-established, monumented, re-monumented, recovered, found as expressed below:


NOTE: Not more than 4 corners, all in the same town and range, may be recorded on this certificate.

A. Description of original monument and accessories and/or subsequent restoration:

POST, G.L.O.
1817

B. Description of corner evidence found and/or method applied in restoring or reestablishing corner:

I FOUND A P.K. NAIL IN THE CENTER OF THE NORTHBOUND LANE OF WILLIAMS LAKE ROAD. A MEASUREMENT NORTH OF 2674.13 FEET MATCHED THE DISTANCE AS SHOWN ON SURVEY BY J. JEWELL (1945). CORNER IS ON WHITE LAKE TOWNSHIP LINE.

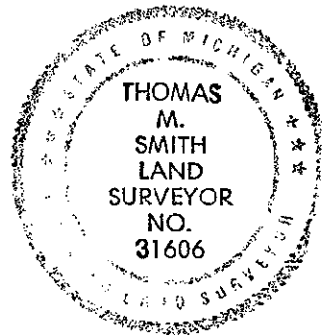

C. Description of monument for corner and accessories established to perpetuate locating the position of the corner:

A-8, I REPLACED THE P.K. NAIL WITH A 5/8" ROD WITH BRASS REMON. CAP #31606 IN A NEW MONUMENT BOX.
S 10 E 90.44 to remon tag in W. Side twin 24" oaks
N 20 E, 90.35 to remon tag W. Side 12" Oak
N 35 W, 73.18 to remon tag E. Side 8" Oak
South, 208.86 to 5/8" rod w/Remon Cap. in MONument Box. (M-8; WHITE LAKE TWP.)

7.00
2.00

Signed by [Signature]

Date DECEMBER 19, 1994

Surveyor's Michigan License No. 31606