

**SURVEY & REMONUMENTATION**

Mar 10 95 040459

MAY - 1 1995

LIBER 15288 PG 549

OK - T. SMITH

**COMMISSION**

**LAND CORNER RECORDATION CERTIFICATE**

Filing Requirement of Act 74, Mich. P.A. 1970

For corners in

OAKLAND

(County)

Located In: WATERFORD

Corner Code #

- 1. Public Land Survey T 3 N R 9 E B-7  
 T \_\_\_\_\_ R \_\_\_\_\_  
 T \_\_\_\_\_ R \_\_\_\_\_  
 T \_\_\_\_\_ R \_\_\_\_\_
- 2. Property Controlling S \_\_\_\_\_ T \_\_\_\_\_ R \_\_\_\_\_  
 in Section S \_\_\_\_\_ T \_\_\_\_\_ R \_\_\_\_\_
- 3. Miscellaneous S \_\_\_\_\_ T \_\_\_\_\_ R \_\_\_\_\_  
 Property in Sec. S \_\_\_\_\_ T \_\_\_\_\_ R \_\_\_\_\_

7.00 MISC RECORDING CHG - IN HOUSE  
 \$ 2.00 REMON CHG - IN HOUSE  
 10 MAR 95 4:12 P.M. RECEIPT# 1788  
 PAID RECORDED - OAKLAND COUNTY  
 LYNN D. ALLEN, CLERK/REGISTER OF DEEDS

Compliance with ACT 345, P.A. 1990

APPROVED ON: 12-30-94  
 OAKLAND COUNTY REMONUMENTATION  
 PEER GROUP COMMITTEE

Register of Deeds Stamp & File Number

- 4. Lot No. \_\_\_\_\_, Recorded Plat \_\_\_\_\_
- 5. Private Claims \_\_\_\_\_

A	B	C	D	E	F	G	H	I	J	K	L	M
2	6	5	4	3	2	1						
3												
4	7	8	9	10	11	12						
5												
6	18	17	16	15	14	13						
7	●											
8	19	20	21	22	23	24						
9												
10	30	29	28	27	26	25						
11												
12	31	32	33	34	35	36						
13												

I, THOMAS M. SMITH, in a field survey on DECEMBER 1, 19 94, do hereby certify that under requirements of P.A. 74, Michigan P.A. of 1970, the corner points mentioned in lines 1 and 2 above were in conformance with regulations and rules therefore as required in the current manual of survey instructions of the United States Department of the Interior, Bureau of Land Management or by a decree of a Court of Law and/or that the corner points mentioned in lines 3, 4 and 5 above were in conformance with the rules of the Michigan Board of Land Surveyors or by a Decree of a Court of Law; established, re-established, monumented, re-monumented, recovered, found as expressed below:


**NOTE: Not more than 4 corners, all in the same town and range, may be recorded on this certificate.**

A. Description of original monument and accessories and/or subsequent restoration:

POST, G.L.O. 1817	concrete monument SUPERVISOR'S PLAT NO. 27 1944	concrete monument ROAD COMMISSION 1963	concrete monument L.C.R.C. L. 10661, PG. 497 1988(LOHFF)
----------------------	---	--	---

B. Description of corner evidence found and/or method applied in restoring or reestablishing corner:

I FOUND A SQUARE 4" CONCRETE MONUMENT AT THE REAR OF LOT 65, S/P NO. 27. I VERIFIED CORNER FROM ROAD COMMISSION WITNESSES AND WITNESSES IN LIBER 10661, PAGE 497. I BELIEVE THE MONUMENT RECOVERED IS THE MONUMENT THAT WAS SET IN 1944 FOR THE SUPERVISOR'S PLAT NO. 27, A MEASUREMENT OF 2261.03 FEET WAS MEASURED WEST, COMPARED TO 2261.39 AS PLATTED. THE CONCRETE MONUMENT IS SLIGHTLY EAST OF PLUMB, AND IS APPROX. 2 FEET EAST OF A CYCLONE FENCE CORNER.

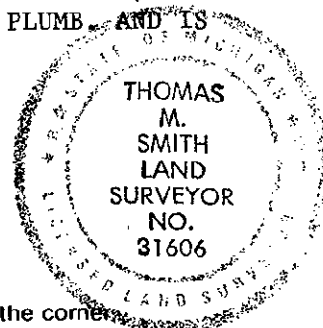

C. Description of monument for corner and accessories established to perpetuate locating the position of the corner:

B-7. I PLACED A BRASS CAP ON THE EXISTING 4" SQUARE CONCRETE MONUMENT.

East, 18.48 to remon tag S. side of 4" ELM  
 S 15 E, 30.90 to remon tag E. Side 18" Oak  
 West, 2.56 to the center of a corner fence post  
 North, 32.11 to remon tag E. Side 10" Wild Cherry

7.00  
2.00

THE SELCTED LOCATION IS ACCEPTED BY ME AND IS GENERALLY ACCPETED BY PROFESSIONAL SURVEYORS AS THE BEST AVAILABLE EVIDENCE OF THE POSITION OF THE ORIGINAL CORNER.

Signed by [Signature] Date DECEMBER 19, 1994

Surveyor's Michigan License No. 31606