

SURVEY & REMONUMENTATION

MAR 10 95 040458

LIBER 15288 PG 548

OK - T. SMITH

MAY - 1 1995

LAND CORNER RECORDATION CERTIFICATE

Filing Requirement of Act 74, Mich. P.A. 1970

\$ 7.00 MISC RECORDING CHG - IN HOUSE
 \$ 2.00 REMON CHG - IN HOUSE
 10 MAR 95 4:12 P.M. RECEIPT# 1788
 PAID RECORDED - OAKLAND COUNTY
 LYNN D. ALLEN, CLERK/REGISTER OF DEEDS

For corners in

COMMISSION

OAKLAND

(County)

Located In: WATERFORD

Corner Code ##

- 1. Public Land Survey T 3 N R 9 E B-9
- T _____ R _____
- T _____ R _____
- T _____ R _____
- 2. Property Controlling S _____ T _____ R _____
- in Section S _____ T _____ R _____
- 3. Miscellaneous S _____ T _____ R _____
- Property in Sec. S _____ T _____ R _____

Compliance with ACT 345, P.A. 1990

APPROVED ON: 12-30-94
 OAKLAND COUNTY REMONUMENTATION
 PEER GROUP COMMITTEE

Register of Deeds Stamp & File Number

- 4. Lot No. _____, Recorded Plat _____
- 5. Private Claims _____

	A	B	C	D	E	F	G	H	I	J	K	L	M
2	6		5		4		3		2		1		
3													
4	7		8		9		10		11		12		
5													
6	18		17		16		15		14		13		
7													
8	19		20		21		22		23		24		
9													
10	30		29		28		27		26		25		
11													
12	31		32		33		34		35		36		
13													

I, THOMAS M. SMITH, in a field survey on DECEMBER 1, 19 94, do hereby certify that under requirements of P.A. 74, Michigan P.A. of 1970, the corner points mentioned in lines 1 and 2 above were in conformance with regulations and rules therefore as required in the current manual of survey instructions of the United States Department of the Interior, Bureau of Land Management or by a decree of a Court of Law and/or that the corner points mentioned in lines 3, 4 and 5 above were in conformance with the rules of the Michigan Board of Land Surveyors or by a Decree of a Court of Law; established, re-established, monumented, re-monumented, recovered, found as expressed below:


NOTE: Not more than 4 corners, all in the same town and range, may be recorded on this certificate.

A. Description of original monument and accessories and/or subsequent restoration:

POST, G.L.O. 1817 1/2" ROD,
 L.C.R.C.
 L. 10661, PAGE 497
 LOHFF

B. Description of corner evidence found and/or method applied in restoring or reestablishing corner:

I FOUND A 1/2 INCH ROD APPROX. 5 FEET SOUTH OF THE SOUTHERLY EDGE OF ASPHALT. A FENCE LINE RUNS NORTH, NORTH OF ELIZABETH LAKE ROAD. ALL WITNESSES FOUND IN LIBER 10661, PAGE 497 WERE USE TO VERIFY THE CORNER. MEASURED DISTANCES TO THE EAST & WEST MEASURE CLOSELY TO PREVIOUSLY PLATTED DISTANCES.

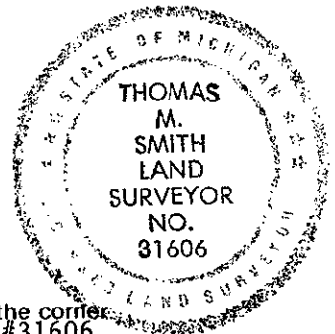

C. Description of monument for corner and accessories established to perpetuate locating the position of the corner:

B-9: I REPLACED THE 1/2 INCH ROD WITH A CONCRETE MONUMENT WITH BRASS CAP #31606

- S 65 E, 72.31 to remon tag N. Side 8" Spruce
- South 60.97 to remon tag W. Side 18" Hickory
- S 85 W, 61.91 to remon tag N. Side 14" Oak
- N 10 E, 70.76 to remon tag W. Side 10" Spruce

7.00
2.00

THE SELECTED LOCATION IS ACCEPTED BY ME AND IS GENERALLY ACCEPTED BY PROFESSIONAL SURVEYORS AS THE BEST AVAILBE EVIDENCE OF THE POSITION OF THE ORIGINAL CORNER

Signed by [Signature]

Date DECEMBER 19, 1994

Surveyor's Michigan License No. 31606