

MAY 24 2000

LIBER 21146 056

SECTION

LAND CORNER RECORDATION CERTIFICATE
Filing Requirement of Act 74, Mich. P.A. 1970

59619

For corners in

Table with columns: Oakland (county), Located In: Waterford Township, Corner Code # C-6. Rows include Public Land Survey, Property Controlling in Section, and Miscellaneous Property in Sec.

LIBER 21146 PAGE 56
\$9.00 MISC RECORDING
\$2.00 REMONUMENTATION
02/29/2000 10:58:27 A.M. RECEIPT# 16518
PAID RECORDED - OAKLAND COUNTY
G. WILLIAM CADDELL, CLERK/REGISTER OF DEEDS

APPROVED ON: 12-14-99 5h
OAKLAND COUNTY REMONUMENTATION
PERM GROUP COMMITTEE

Register of Deeds Stamp & File Number

4. Lot No. Recorded Plat

5. Private Claims

I, Joseph C. Kapelczak, in a field survey on May 19, 1999, do hereby certify that under requirements of P.A. 74, Michigan P.A. of 1970, the corner points mentioned in lines 1 and 2 above were in conformance with regulations and rules therefore as required in the current manual of survey instructions of the United States Department of the Interior, Bureau of Land Management or by a decree of a Court of Law and/or that the corner points mentioned in lines 3, 4 and 5 above were in conformance with the rules of the Michigan Board of Land Surveyors or by a Decree of a Court of Law, established, re-established, monumented, re-monumented, recovered, found as expressed below:

Grid table with columns A-M and rows 2-13. Cell (6,17) contains a small diagram of a corner point.

A. Description of original monument and accessories and/or subsequent restoration:

Set post in 1816 G.L.O. Survey.

There is one LCRC recorded at Oakland County; Scharl 1990.

B. Description of corner evidence found and/or method applied in restoring or reestablishing corner:

No monumentation was recovered at this location as it falls within the runway of 9R Oakland International Airport. This location was re-established and validated with monumentation located in Astro Park Subdivision No. 1 and S/P of Paulsen Circle Subdivision. A reference monument was placed 420.00' north of C-6 on the section line between C-6 and C-5.


C. Description of monument for corner and accessories established to perpetuate locating the position of the corner:

Set reference monument 420.00' north of C-6 on the section line between C-6 and C-5.

Set Witnesses for reference monument:

- N 73°18'W 58.91' set Mag nail with OCRT#24598 in south side 18" Oak.
N 60°25'W 36.62' set Mag nail with OCRT #24598 in south side 10" Oak.
N 12°48'E 66.43' set Mag nail with OCRT #24598 in west side 26" Oak.
N 81°50'E 54.41' set Mag nail with OCRT #24598 east side 8" Oak.

Handwritten initials 'ZP' and 'R'.

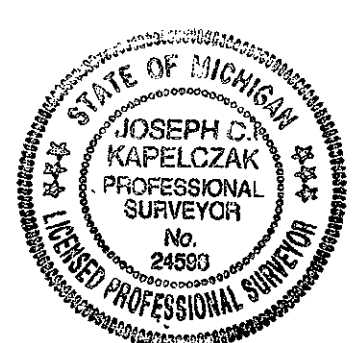

Signed by Joseph C. Kapelczak

Date 12/22/99

Surveyor's Michigan License No. 24598