

**SURVEY & REMONUMENTATION**

MAR 10 95 040457

LIBER 15288 PC 547

OK - T. SMITH

MAY - 1 1995

**LAND CORNER RECORDATION CERTIFICATE**

Filing Requirement of Act 74, Mich. P.A. 1970

\$ 7.00 MISC RECORDING CHG - IN HOUSE  
 \$ 2.00 REMON CHG - IN HOUSE  
 10 MAR 95 4:11 P.M. RECEIPT# 1788  
 PAID RECORDED - OAKLAND COUNTY  
 LYNN D. ALLEN, CLERK/REGISTER OF DEEDS

For corners in

**COMMISSION**

OAKLAND  
(County)

Located in: WATERFORD

Corner Code #

- 1. Public Land Survey T 3 N R 9 E C-8
- T \_\_\_\_\_ R \_\_\_\_\_
- T \_\_\_\_\_ R \_\_\_\_\_
- T \_\_\_\_\_ R \_\_\_\_\_
- 2. Property Controlling S \_\_\_\_\_ T \_\_\_\_\_ R \_\_\_\_\_
- in Section S \_\_\_\_\_ T \_\_\_\_\_ R \_\_\_\_\_
- 3. Miscellaneous S \_\_\_\_\_ T \_\_\_\_\_ R \_\_\_\_\_
- Property in Sec. S \_\_\_\_\_ T \_\_\_\_\_ R \_\_\_\_\_

Compliance with  
ACT 345, P.A. 1990

APPROVED ON: 12-30-94  
 OAKLAND COUNTY REMONUMENTATION  
 PEER GROUP COMMITTEE

Register of Deeds Stamp & File Number

- 4. Lot No. \_\_\_\_\_, Recorded Plat \_\_\_\_\_
- 5. Private Claims \_\_\_\_\_

	A	B	C	D	E	F	G	H	I	J	K	L	M
2	6		5		4		3		2		1		
3													
4	7		8		9		10		11		12		
5													
6	18		17		16		15		14		13		
7													
8	19		20		21		22		23		24		
9													
10	30		29		28		27		26		25		
11													
12	31		32		33		34		35		36		
13													

I, THOMAS M. SMITH, in a field survey on DECEMBER 1, 19 94, do hereby certify that under requirements of P.A. 74, Michigan P.A. of 1970, the corner points mentioned in lines 1 and 2 above were in conformance with regulations and rules therefore as required in the current manual of survey instructions of the United States Department of the Interior, Bureau of Land Management or by a decree of a Court of Law and/or that the corner points mentioned in lines 3, 4 and 5 above were in conformance with the rules of the Michigan Board of Land Surveyors or by a Decree of a Court of Law; established, re-established, monumented, re-monumented, recovered, found as expressed below:


**NOTE: Not more than 4 corners, all in the same town and range, may be recorded on this certificate.**

**A. Description of original monument and accessories and/or subsequent restoration:**

POST, G.L.O. 1817      ½" PIPE ROAD COMMISSION 1963      1" IRON, L.C.R.C. L. 7177, PG. 606 JONES, 1978

**B. Description of corner evidence found and/or method applied in restoring or reestablishing corner:**

I FOUND A ½ INCH ROD IN A MONUMENT BOX AT THE INTERSECTION OF PONTIAC LAKE ROAD & HOSPITAL ROAD. A VERIFIED THE CORNER BY MEASURING TO THE N.W. RIGHT-OF-WAY CORNER OF WATERFORD OAKS ESTATES PLAT. ALL WITNESSES WERE OBLITERATED DUE TO ROAD CONSTRUCTION. I VERIFIED THE CORNER BY MEASURING SOUTHERLY TO A RIGHT-OF-WAY MONUMENT IN MARCO HEIGHTS PLAT TO WITHIN 0.03 FEET. MEASUREMENTS WERE TAKEN NORTH & SOUTH TO THE SECTION CORNERS.

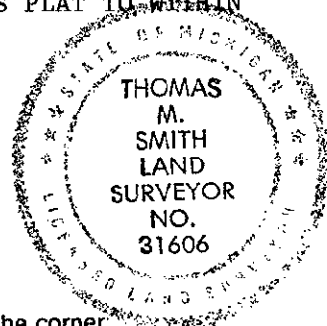

**C. Description of monument for corner and accessories established to perpetuate locating the position of the corner:**

C-8: I REPLACED THE ½" ROD WITH A 5/8" ROD WITH A BRASS CAP #31606 IN THE MONUMENT BOX.  
 N 45 W, 105.35' to remon tag N.E side 14" oak  
 S 20 W, 60.58' to most SELY corner C.B. frame.  
 N 40 W 77.10' to most NWLY corner C.B. frame.  
 N 20 E, 64.87' to most NELY corner C.B. frame.

7.00  
2.00

THE SELECTED LOCATION IS ACCEPTED BY ME AND IS GENERALLY ACCEPTED BY PROFESSIONAL SURVEYORS AS THE BEST AVAILABLE EVIDENCE OF THE POSITION OF THE ORIGINAL CORNER.

Signed by [Signature]

Date DECEMBER 19, 1994

Surveyor's Michigan License No. 31606