

**SURVEY &
REMONUMENTATION**

MAR 10 95 040455

LIBER 15288 PC 545

OK - T. SMITH

MAY - 1 1995

LAND CORNER RECORDATION CERTIFICATE

Filing Requirement of Act 74, Mich. P.A. 1970

For corners in
OAKLAND
(County)

COMMISSION

Located in: WATERFORD Corner Code #

7.00 MISC RECORDING CHG - IN HOUSE
\$ 2.00 REMON CHG - IN HOUSE
10 MAR 95 4:11 P.M. RECEIPT# 1788
PAID RECORDED - OAKLAND COUNTY
LYNN D. ALLEN, CLERK/REGISTER OF DEEDS

- 1. Public Land Survey T 3 N R 9 E C-11
T R
T R
T R
- 2. Property Controlling S T R
in Section S T R
- 3. Miscellaneous S T R
Property in Sec. S T R

Compliance with
ACT 345, P.A. 1990
APPROVED ON: 12-30-94
OAKLAND COUNTY REMONUMENTATION
PEER GROUP COMMITTEE
Register of Deeds Stamp & File Number

- 4. Lot No. _____, Recorded Plat _____
- 5. Private Claims _____

A	B	C	D	E	F	G	H	I	J	K	L	M
2	6	5	4	3	2	1						
3												
4	7	8	9	10	11	12						
5												
6	18	17	16	15	14	13						
7												
8	19	20	21	22	23	24						
9												
10	30	29	28	27	26	25						
11												
12	31	32	33	34	35	36						
13												


I, THOMAS M. SMITH, in a field survey on DECEMBER 1, 1994, do hereby certify that under requirements of P.A. 74, Michigan P.A. of 1970, the corner points mentioned in lines 1 and 2 above were in conformance with regulations and rules therefore as required in the current manual of survey instructions of the United States Department of the Interior, Bureau of Land Management or by a decree of a Court of Law and/or that the corner points mentioned in lines 3, 4 and 5 above were in conformance with the rules of the Michigan Board of Land Surveyors or by a Decree of a Court of Law; established, re-established, monumented, re-monumented, recovered, found as expressed below:

NOTE: Not more than 4 corners, all in the same town and range, may be recorded on this certificate.

A. Description of original monument and accessories and/or subsequent restoration:
 POST G.L.O. 1817 3/4 "PIPE INSIDE 1 1/2" IRON PIPE ROAD COMMISSION 1963 1/2" IRON ROD. L.C.R.C. L.12208 P.634 J.SMITH

B. Description of corner evidence found and/or method applied in restoring or reestablishing corner:

I FOUND A 1/2" ROD IN A MONUMENT BOX IN THE CENTERLINE OF HOSPITAL ROAD. I RECOVERED THE CORNER BY USING THE REMAINING WITNESSES FROM J. SMITH SURVEY AND J. SCHARL SURVEY. DISTANCES MEASURED SOUTH TO C-12 HIT VERY CLOSE TO THE RECORDED DISTANCES. A PROMINENT STONE PILLAR IS DUE WEST OF THE CORNER WITH A TREE ROW EXTENDING WESTERLY, A DRAINAGE DITCH RUNS EASTERLY FROM THE CORNER.

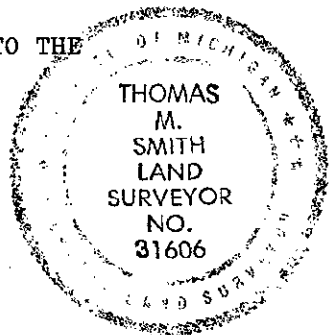

C. Description of monument for corner and accessories established to perpetuate locating the position of the corner:

C-11 I REPLACED THE 1/2" ROD WITH A 5/8" ROD WITH A BRASS CAP #31606 IN THE MONUMENT BOX.
 N. 75 E, 74.95' to remon tag S. side box elder.
 S. 30 E, 74.84' top center FIRE HYD.
 WEST 72.92' to remon tag S. side 14" elm
 N. 40 W. 85.78' to remon tag S. side 10" clump maples

7.00
2.00

THE SELECTED LOCATION IS ACCEPTED BY ME AND IS GENERALLY ACCEPTED BY PROFESSIONAL SURVEYORS AS THE BEST AVAILABLE EVIDENCE OF THE ORIGINAL CORNER.

Signed by [Signature]

Date DECEMBER 19, 1994

Surveyor's Michigan License No. 31606