

SURVEY & REMONUMENTATION

MAY - 1 1995

LIBER **15288PC544**

Mar 10 95 040454

OK - T. SMITH

COMMISSION LAND CORNER RECORDATION CERTIFICATE
 Filing Requirement of Act 74, Mich. P.A. 1970

\$ 7.00 NISC RECORDING CHG - IN HOUSE
 \$ 2.00 REMON CHG - IN HOUSE
 10 MAR 95 4:10 P.M. RECEIPT# 1788
 PAID RECORDED - OAKLAND COUNTY
 LYNN D. ALLEN, CLERK/REGISTER OF DEEDS

For corners in
OAKLAND
 (County)

Located in: WATERFORD Corner Code #

- 1. Public Land Survey T 3 N R 9 E C-12
 T R
 T R
 T R
- 2. Property Controlling S T R
 in Section S T R
- 3. Miscellaneous S T R
 Property in Sec. S T R

Compliance with
 ACT 345, P.A. 1990
 APPROVED ON: 12-30-94
 OAKLAND COUNTY REMONUMENTATION
 PEER GROUP COMMITTEE
 Register of Deeds Stamp & File Number

- 4. Lot No. _____, Recorded Plat _____
- 5. Private Claims _____


I, THOMAS M. SMITH, in a field survey on DECEMBER 1, 19 94, do hereby certify that under requirements of P.A. 74, Michigan P.A. of 1970, the corner points mentioned in lines 1 and 2 above were in conformance with regulations and rules therefore as required in the current manual of survey instructions of the United States Department of the Interior, Bureau of Land Management or by a decree of a Court of Law and/or that the corner points mentioned in lines 3, 4 and 5 above were in conformance with the rules of the Michigan Board of Land Surveyors or by a Decree of a Court of Law; established, re-established, monumented, re-monumented, recovered, found as expressed below:

NOTE: Not more than 4 corners, all in the same town and range, may be recorded on this certificate.

	A	B	C	D	E	F	G	H	I	J	K	L	M
2	6		5		4		3		2		1		
3													
4	7		8		9		10		11		12		
5													
6	18		17		16		15		14		13		
7													
8	19		20		21		22		23		24		
9													
10	30		29		28		27		26		25		
11													
12	31		32		33		34		35		36		
13													

A. Description of original monument and accessories and/or subsequent restoration:
 POST G.L.O. NO L.C.R.C. RECORDED.
 1817

B. Description of corner evidence found and/or method applied in restoring or reestablishing corner:
 I FOUND A 1/2" ROD IN A MONUMENT BOX IN THE CENTERLINE OF HOSPITAL ROAD. I VERIFIED THE CORNER BY LOCATING A CONCRETE MONUMENT 60 FEET WEST AND A PIPE 60 FEET EAST. A TREE ROW RUNS EAST & WEST FROM THE CORNER. MEASURED DISTANCES NORTH & SOUTH MATCH CLOSELY WITH RECORDED DIMENSIONS.

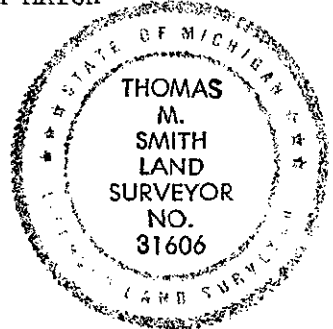

C. Description of monument for corner and accessories established to perpetuate locating the position of the corner:
 C-12: I REPLACED THE 1/2" ROD WITH A 5/8" ROD WITH A BRASS CAP #31606 IN THE MONUMENT BOX.
 S 45 E. 60.47' to the bottom of the " T " in the word GATE
 EAST 66.95' to remon tag S. side 14" oak
 N. 75 E. 68.90' to remon tag N. side power pole.
 S. 75 W. 77.07' to remon tag S. side 20" oak.
 S. 50 W. 64.24' to remon tag S. side 20" oak.

7.00
 2.00

THE SELECTED LOCATION IS ACCEPTED BY ME AND IS GENERALLY ACCEPTED BY PROFESSIONAL SURVEYORS AS THE BEST AVAILABLE EVIDENCE OF THE ORIGINAL CORNER.

Signed by [Signature] Date DECEMBER 19, 1994

Surveyor's Michigan License No. 31606