MAR 10 95 04 04 53

SURVEY & REMONUMENTATION

LIBER 15288 PG 543

OK - T. SMITH

MAY - 1 1995

COMMISSION

LAND CORNER RECORDATION CERTIFICATE

Filing Requirement of Act 74, Mich. P.A. 1970

For corners in OAKLAND (County) Located In: WATERFORD Corner Code ##

$ 7.00 MISC RECORDING CHG - IN HOUSE
$ 2.00 REMON CHG - IN HOUSE
10 MAR 95 4:10 P.M. RECEIPT# 178B
PAID RECORDED - OAKLAND COUNTY
LYNN D. ALLEN, CLERK/REGISTER OF DEEDS

Compliance with ACT 345, P.A. 1990

APPROVED ON: 12-30-94
OAKLAND COUNTY REMONUMENTATION PEER GROUP COMMITTEE

Register of Deeds Stamp & File Number

1. Public Land Survey T 3 N R 9 E D-3
   T ___ R ___
   T ___ R ___
   T ___ R ___
2. Property Controlling S ___ T ___ R ___
   in Section S ___ T ___ R ___
3. Miscellaneous S ___ T ___ R ___
   Property in Sec. S ___ T ___ R ___

4. Lot No. _____ , Recorded Plat _____
5. Private Claims _____

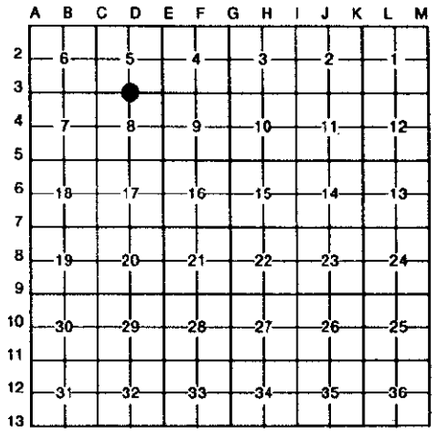

I, THOMAS M. SMITH, in a field survey on DECEMBER 2, 19 94, do hereby certify that under requirements of P.A. 74, Michigan P.A. of 1970, the corner points mentioned in lines 1 and 2 above were in conformance with regulations and rules therefore as required in the current manual of survey instructions of the United States Department of the Interior, Bureau of Land Management or by a decree of a Court of Law and/or that the corner points mentioned in lines 3, 4 and 5 above were in conformance with the rules of the Michigan Board of Land Surveyors or by a Decree of a Court of Law; established, re-established, monumented, re-monumented, recovered, found as expressed below:

NOTE: Not more than 4 corners, all in the same town and range, may be recorded on this certificate.

A. Description of original monument and accessories and/or subsequent restoration:

POST G.L.O. 1817 NO L.C.R.C. RECORDED

B. Description of corner evidence found and/or method applied in restoring or reestablishing corner:

I FOUND A P.K. NAIL IN THE CENTERLINE OF MACEDAY DRIVE. I VERIFIED THAT CORNER POSITION BY TIEING INTO A CONCRETE MONUMENT APPROX. 300 FEET SOUTH OF THE NAIL. THIS MATCHED VERY CLOSELY WITH THE PLAT WHITFIELD ESTATES NO. 2. A SPLIT RAIL FENCE RUNS SOUTH FROM THE CORNER.

STATE OF MICHIGAN
THOMAS M. SMITH LAND SURVEYOR NO. 31606
LAND SURVEYOR

C. Description of monument for corner and accessories established to perpetuate locating the position of the corner:

D-3: I REPLACED THE P.K. NAIL WITH A 5/8" ROD WITH BRASS REMON CAP #31606 IN A NEW MONUMENT BOX.
S 8o W. 82.58' to remon tag N.E. side 18" poplar
S 05 E. 66.83' to N.W. corner HSE. #6499
S 10 W. 66.44' to remon tag W. side 5" cedar
NORTH 15.88' to S. edge conc. sidewalk.

7.00
2.00

THE SELECTED LOCATION IS ACCEPTED BY ME AND IS GENERALLY ACCEPTED BY PROFESSIONAL SURVEYORS AS THE BEST AVAILABLE EVIDENCE OF THE ORIGINAL CORNER.

Signed by _____ Date DECEMBER 19, 1994

Surveyor's Michigan License No. 31606

FORM APPROVED BY MICHIGAN STATE BOARD OF LAND SURVEYORS, JAN. 28, 1971
REVISED MAY 14, 1975
REVISED JAN., 1983