

SURVEY & REMONUMENTATION

LIBER 15290 PG 574

MAR 14 95 04 15 88

OK - T. SMITH

MAY - 1 1995

LAND CORNER RECORDATION CERTIFICATE 7.00 MISC RECORDING CHG - IN HOUSE

For corners in OAKLAND

COMMISSION

Filing Requirement of Act 74, Mich. P.A. 1970, 2.00 REMON CHG - IN HOUSE

14 MAR 95 9:14 A.M. RECEIPT# 45B
PAID RECORDED - OAKLAND COUNTY
LYNN D. ALLEN, CLERK/REGISTER OF DEEDS

(County)	Located In:	Corner Code #/
	WATERFORD	
1. Public Land Survey	T 3 N R 9 E	D-7
	T _____ R _____	_____
	T _____ R _____	_____
	T _____ R _____	_____
2. Property Controlling in Section	S _____ T _____ R _____	_____
	S _____ T _____ R _____	_____
3. Miscellaneous Property in Sec.	S _____ T _____ R _____	_____
	S _____ T _____ R _____	_____

Compliance with ACT 345, P.A. 1990

APPROVED ON: 12-30-94
OAKLAND COUNTY REMONUMENTATION PEER GROUP COMMITTEE

Register of Deeds Stamp & File Number

- 4. Lot No. _____, Recorded Plat _____
- 5. Private Claims _____

	A	B	C	D	E	F	G	H	I	J	K	L	M
2	6	5	4	3	2	1							
3													
4	7	8	9	10	11	12							
5													
6	18	17	16	15	14	13							
7		●											
8	19	20	21	22	23	24							
9													
10	30	29	28	27	26	25							
11													
12	31	32	33	34	35	36							
13													

I, THOMAS M. SMITH, in a field survey on DECEMBER 2, 19 94, do hereby certify that under requirements of P.A. 74, Michigan P.A. of 1970, the corner points mentioned in lines 1 and 2 above were in conformance with regulations and rules therefore as required in the current manual of survey instructions of the United States Department of the Interior, Bureau of Land Management or by a decree of a Court of Law and/or that the corner points mentioned in lines 3, 4 and 5 above were in conformance with the rules of the Michigan Board of Land Surveyors or by a Decree of a Court of Law; established, re-established, monumented, re-monumented, recovered, found as expressed below:

NOTE: Not more than 4 corners, all in the same town and range, may be recorded on this certificate.


A. Description of original monument and accessories and/or subsequent restoration:

POST. G.L.O.	MON. BOX.	MDSHT RLS# 19841	IRON IN MON. BOX.
1817	ROAD COMMISSION	IN MON BOX.	UNRECORDED STONEROCK SURVEY
	1963	L.C.R.C.	
		L. 7400 P. 313	
		HOOTH, 1978	

B. Description of corner evidence found and/or method applied in restoring or reestablishing corner:

I FOUND A MDOT DISK ON TOP OF A ROD IN A MONUMENT BOX IN THE CENTER TURN LANE OF M-59 HIGHWAY. I RECOVERED THE CORNER BY USING THE WITNESS FROM THE STONEROCK SURVEY. MEASURED DISTANCES MATCH THE 1933 SURVEY OF THE PONTIAC AIRPORT WITHIN 0.50 FEET OF LESS. A FENCE ROW RUNS SOUTH FROM THE CORNER.

7.00
2.00
TH. O.

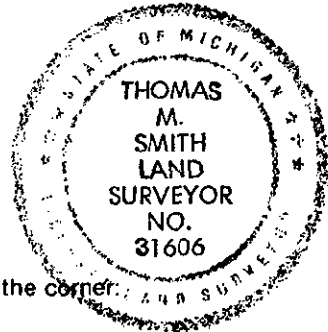

C. Description of monument for corner and accessories established to perpetuate locating the position of the corner:

D-7: I REPLACE THE MDOT DISK WITH A 5/8" ROD AND A BRASS CAP.
NORTH 47.73' to top center fire hyd.
S 45 E. 50.17' to S.W. corner of C.B. frame.
N 55 E. 48.97' to chis. " X " on top rim C.B.
S 55 E. 104.45' to N.W. corner building

THE LOCATION IS ACCEPTED BY ME AND IS GENERALLY ACCEPTED BY PROFESSIONAL SURVEYORS AS THE BEST AVAILABLE EVIDENCE OF THE ORIGINAL CORNER.

Signed by [Signature] Date DECEMBER 19, 1994

Surveyor's Michigan License No. 31606