

**SURVEY &
REMONUMENTATION**

LIBER. **15288** PG **542**

MAR 10 95 040452
OK - T. SMITH

MAY - 1 1995

LAND CORNER RECORDATION CERTIFICATE

COMMISSION

Filing Requirement of Act 74, Mich. P.A. 1970

For corners in
OAKLAND

(County)

Located In: WATERFORD

Corner Code #

- | | | |
|------------------------------------|------------------------------------|------------|
| 1. Public Land Survey | T <u>3</u> N <u>9</u> R <u>9</u> E | <u>D-9</u> |
| | T _____ R _____ | _____ |
| | T _____ R _____ | _____ |
| | T _____ R _____ | _____ |
| 2. Property Controlling in Section | S _____ T _____ R _____ | _____ |
| | S _____ T _____ R _____ | _____ |
| 3. Miscellaneous Property in Sec. | S _____ T _____ R _____ | _____ |
| | S _____ T _____ R _____ | _____ |

\$ 7.00 MISC RECORDING CHG - IN HOUSE
\$ 2.00 REMON CHG - IN HOUSE
10 MAR 95 4:10 P.M. RECEIPT# 1788
PAID RECORDED - OAKLAND COUNTY
LYNN D. ALLEN, CLERK/REGISTER OF DEEDS

Compliance with
ACT 345, P.A. 1990

APPROVED ON: 12-30-94
OAKLAND COUNTY REMONUMENTATION
PEER GROUP COMMITTEE

Register of Deeds Stamp & File Number

4. Lot No. _____, Recorded Plat _____
5. Private Claims _____

I, THOMAS M. SMITH, in a field survey on DECEMBER 2, 19 94, do hereby certify that under requirements of P.A. 74, Michigan P.A. of 1970, the corner points mentioned in lines 1 and 2 above were in conformance with regulations and rules therefore as required in the current manual of survey instructions of the United States Department of the Interior, Bureau of Land Management or by a decree of a Court of Law and/or that the corner points mentioned in lines 3, 4 and 5 above were in conformance with the rules of the Michigan Board of Land Surveyors or by a Decree of a Court of Law; established, re-established, monumented, re-monumented, recovered, found as expressed below:

NOTE: Not more than 4 corners, all in the same town and range, may be recorded on this certificate.

	A	B	C	D	E	F	G	H	I	J	K	L	M
2	6	5	4	3	2	1							
3													
4	7	8	9	10	11	12							
5													
6	18	17	16	15	14	13							
7													
8	19	20	21	22	23	24							
9		●											
10	30	29	28	27	26	25							
11													
12	31	32	33	34	35	36							
13													

A. Description of original monument and accessories and/or subsequent restoration:

POST, G.L.O.	BOAT SPIKE	IRON ROD
1817	ROAD COMMISSION.	L.C.R.C.
	1963	L. 6381 P. 654
		JONES,


B. Description of corner evidence found and/or method applied in restoring or reestablishing corner:

I FOUND A BOAT SPIKE IN THE ASPHALT AND A 1/2" ROD 0.10 NORTH OF THE BOAT SPIKE. THE BOAT SPIKE WAS IDENTIFIED AS THE CORNER IN 1963 AND WAS ACCEPTED AS THE CORNER OVER THE RE-ROD. A CHAIN-LINKED FENCE RUNS NORTH OF THE CORNER.

C. Description of monument for corner and accessories established to perpetuate locating the position of the corner:

D-9: I REPLACED THE BOAT SPIKE WITH A 5/8" ROD AND CAP IN A MONUMENT BOX.
N 15 E. 80.60' to remon. tag E. side 7" pine.
N 05 W. 92.65' to remon. tag W. side 26" oak.
N 60 W. 108.35' to remon. tag N.E. side 8" pine.
S 45 W. 64.69' to remon. tag S.W. side asph. apron.

THE SELECTED LOCATION IS ACCEPTED BY ME AND IS GENERALLY ACCEPTED BY PROFESSIONAL SURVEYORS AS THE BEST AVAILABLE EVIDENCE OF THE ORIGINAL CORNER.

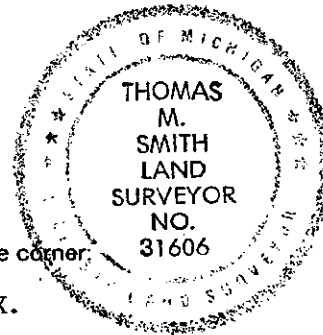

7.00
2.00

Signed by [Signature]

Date DECEMBER 19 1994

Surveyor's Michigan License No. 31606