

**SURVEY & REMONUMENTATION**

LIBER. **15288** PG **540**

MAR 10 95 040450  
OK - T. SMITH

MAY - 1 1995

**LAND CORNER RECORDATION CERTIFICATE**

For corners in **OAKLAND**  
(County)

**COMMISSION**

Located In: **WATERFORD** Corner Code **#**

Filing Requirement of Act 74, Mich. P.A. 1970 **7.00** NISC RECORDING CHG - IN HOUSE


**\$ 2.00** REMON CHG - IN HOUSE  
10 MAR 95 4:10 P.M. RECEIPT# 1788  
PAID RECORDED - OAKLAND COUNTY  
LYNN D. ALLEN, CLERK/REGISTER OF DEEDS

- 1. Public Land Survey T 3 N R 9 E E-2  
T \_\_\_\_\_ R \_\_\_\_\_  
T \_\_\_\_\_ R \_\_\_\_\_  
T \_\_\_\_\_ R \_\_\_\_\_
- 2. Property Controlling S \_\_\_\_\_ T \_\_\_\_\_ R \_\_\_\_\_  
in Section S \_\_\_\_\_ T \_\_\_\_\_ R \_\_\_\_\_
- 3. Miscellaneous S \_\_\_\_\_ T \_\_\_\_\_ R \_\_\_\_\_  
Property in Sec. S \_\_\_\_\_ T \_\_\_\_\_ R \_\_\_\_\_

Compliance with  
ACT 345, P.A. 1990  
APPROVED ON: 12.30.94  
OAKLAND COUNTY REMONUMENTATION  
PEER GROUP COMMITTEE  
Register of Deeds Stamp & File Number

- 4. Lot No. \_\_\_\_\_, Recorded Plat \_\_\_\_\_
- 5. Private Claims \_\_\_\_\_

I, **THOMAS M. SMITH**, in a field survey on **DECEMBER 2**, 19**94**, do hereby certify that under requirements of P.A. 74, Michigan P.A. of 1970, the corner points mentioned in lines 1 and 2 above were in conformance with regulations and rules therefore as required in the current manual of survey instructions of the United States Department of the Interior, Bureau of Land Management or by a decree of a Court of Law and/or that the corner points mentioned in lines 3, 4 and 5 above were in conformance with the rules of the Michigan Board of Land Surveyors or by a Decree of a Court of Law; established, re-established, monumented, re-monumented, recovered, found as expressed below:

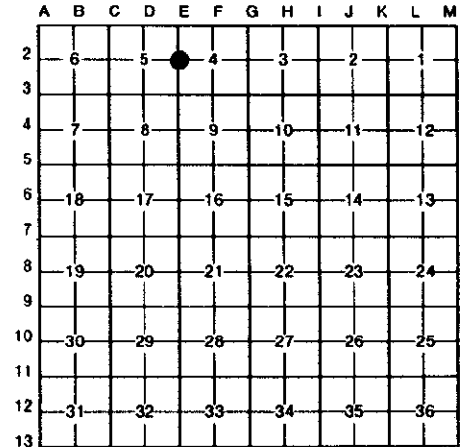


**NOTE: Not more than 4 corners, all in the same town and range, may be recorded on this certificate.**

**A. Description of original monument and accessories and/or subsequent restoration:**

POST, G.L.O. 1817	MON. S.E. CORNER FAIRFIELD HOMES HUNT SURVEY 1976.	SET RAILROAD SPIKE L.C.R.C. L. 9408 P. 02 LOHFF, 1986	RAILROAD SPIKE L.C.R.C. L. 10484 P. 626 STONEROCK, 1988
----------------------	---	--	--

**B. Description of corner evidence found and/or method applied in restoring or reestablishing corner:**

I FOUND A RAILROAD SPIKE IN THE ASPHALT AIRPORT ROAD. UPON CORING FOR A MONUMENT BOX I FOUND A 1/2" PIPE IN THE CONCRETE ROAD BASE OF AIRPORT ROAD UNDER THE ASPHALT. THE P.K. NAIL WAS ABOVE THE PIPE. THE CORNER MATCHES THE ADJOINING PLATS.

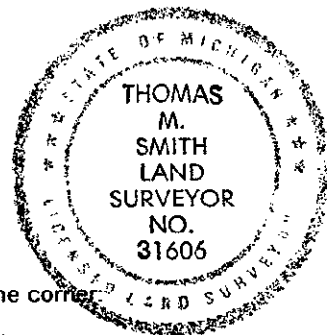

**C. Description of monument for corner and accessories established to perpetuate locating the position of the corner AND 1/2 PIPE**

E-2: I REPLACED THE R.R. SPIKE WITH A 5/8" ROD WITH BRASS REMON CAP #31606 IN A NEW MONUMENT BOX.  
S 30 E. 145.48' to remon tag W. side 18" pine  
EAST 139.22' to remon tag S. side 16" tulip poplar  
N. 85 W. 80.99' to S.E. foundation corner HSE. #3979  
N 30 W. 93.90' to remon tag N.E. side 6" pine

THE SELECTED LOCATION IS ACCEPTED BY ME AND IS GENERALLY ACCEPTED BY PROFESSIONAL SURVEYORS AS THE AVAILABLE EVIDENCE OF THE ORIGINAL CORNER.

Signed by *Thomas M. Smith*

Date **DECEMBER 19, 1994**

Surveyor's Michigan License No. **31606**

7.00  
2.00