

**SURVEY &
REMONUMENTATION**

LIBER **15292** PG **378**

MAR 15 95 04 1990

LAND CORNER RECORDATION CERTIFICATE
Filing Requirement of Act 74, Mich. P.A. 1970

OK - T. SMITH

For corners in MAY - 1 1995

OAKLAND (County) **COMMISSION** Located In: WATERFORD Corner Code #

- | | | |
|------------------------------------|---|-------------|
| 1. Public Land Survey | T <u>3</u> N <u>9</u> E | <u>E-3</u> |
| | T <u> </u> R <u> </u> | <u> </u> |
| | T <u> </u> R <u> </u> | <u> </u> |
| | T <u> </u> R <u> </u> | <u> </u> |
| 2. Property Controlling in Section | S <u> </u> T <u> </u> R <u> </u> | <u> </u> |
| | S <u> </u> T <u> </u> R <u> </u> | <u> </u> |
| 3. Miscellaneous Property in Sec. | S <u> </u> T <u> </u> R <u> </u> | <u> </u> |
| | S <u> </u> T <u> </u> R <u> </u> | <u> </u> |

\$ 7.00 MISC RECORDING CHG - IN HOUSE
\$ 2.00 REMON CHG - IN HOUSE
15 MAR 95 8:09 A.M. RECEIPT# 88
PAID RECORDED - OAKLAND COUNTY
LYNN D. ALLEN, CLERK/REGISTER OF DEEDS
ACT 345, P.A. 1990

APPROVED ON: 12-30-94
OAKLAND COUNTY REMONUMENTATION
PEER GROUP COMMITTEE

Register of Deeds Stamp & File Number

4. Lot No. , Recorded Plat
5. Private Claims

I, THOMAS M. SMITH, in a field survey on DECEMBER 2, 19 94, do hereby certify that under requirements of P.A. 74, Michigan P.A. of 1970, the corner points mentioned in lines 1 and 2 above were in conformance with regulations and rules therefore as required in the current manual of survey instructions of the United States Department of the Interior, Bureau of Land Management or by a decree of a Court of Law and/or that the corner points mentioned in lines 3, 4 and 5 above were in conformance with the rules of the Michigan Board of Land Surveyors or by a Decree of a Court of Law; established, re-established, monumented, re-monumented, recovered, found as expressed below:

A	B	C	D	E	F	G	H	I	J	K	L	N
2	6	5	4	3	2	1						
3												
4	7	8	9	10	11	12						
5												
6	18	17	16	15	14	13						
7												
8	19	20	21	22	23	24						
9												
10	30	29	28	27	26	25						
11												
12	31	32	33	34	35	36						
13												

NOTE: Not more than 4 corners, all in the same town and range, may be recorded on this certificate.


A. Description of original monument and accessories and/or subsequent restoration:

POST G.L.O. 1817 SET RAILROAD SPIKE
L.C.R.C.
L. 10484 P. 626
STONEROCK, 1988

[Handwritten signature]

B. Description of corner evidence found and/or method applied in restoring or reestablishing corner:

I FOUND A RAILROAD SPIKE IN THE INTERSECTION OF AIRPORT ROAD & WILLIAMS LAKE ROAD. STONEROCK SET THIS FROM THE PLAT OF LOTUS LAKE. I VERIFIED THIS POSITION FROM THE PLAT OF JUDSON BRADWAYS HUNTON LAKE SUB.

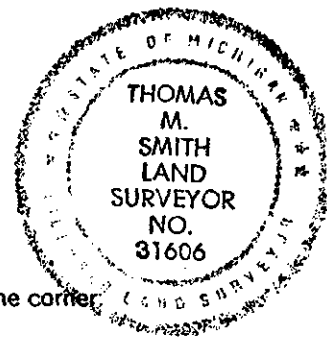

C. Description of monument for corner and accessories established to perpetuate locating the position of the corner:

E-3: I REPLACED THE R.R. SPIKE WITH A 5/8" ROD WITH BRASS REMON CAP #31606 IN A NEW MONUMENT BOX.
S 45 W. 111.75' to remon tag S.E. side 20" oak.
N 60 W. 81.60' to remon tag S.W. side P.P.
N 70 E. 62.60' to remon tag S.E. side P.P.

THE SELECTED LOCATION IS ACCEPTED BY ME AND IS GENERALLY ACCEPTED BY PROFESSIONAL SURVEYORS AS THE AVAILABLE EVIDENCE OF THE ORIGINAL CORNER.

Signed by *[Signature]* Date DECEMBER 19, 1994
Surveyor's Michigan License No. 31606