

MAY 24 2000

LIBER 21119 591

SECTION

LAND CORNER RECORDATION CERTIFICATE

51682

Filing Requirement of Act 74, Mich. P.A. 1970

LIBER 21119 PAGE 591

49.00 MISC RECORDING  
42.00 REMONUMENTATION  
02/18/2000 02:36:27 P.M. RECEIPT# 14203  
PAID RECORDED - OAKLAND COUNTY  
G. WILLIAM CADDELL, CLERK/REGISTER OF DEEDS

For corners in

<u>Oakland</u> (county)	Located In:	Corner Code #
	Waterford Township	
1. Public Land Survey	T3N R9E	E-4
	T_____ R_____	_____
	T_____ R_____	_____
	T_____ R_____	_____
2. Property Controlling In Section	S_____ T_____ R_____	_____
	S_____ T_____ R_____	_____
3. Miscellaneous Property in Sec.	S_____ T_____ R_____	_____
	S_____ T_____ R_____	_____

Compliance with  
ACT 345, P.A. 1990  
APPROVED ON: 12-19-99 JJK  
OAKLAND COUNTY REMONUMENTATION  
PEER GROUP COMMITTEE  
Register of Deeds Stamp & File Number

4. Lot No. \_\_\_\_\_, Recorded Plat \_\_\_\_\_

5. Private Claims \_\_\_\_\_

I, Joseph C. Kapelczak, in a field survey on April 1, 1999, do hereby certify that under requirements of P.A. 74, Michigan P.A. of 1970, the corner points mentioned in lines 1 and 2 above were in conformance with regulations and rules therefore as required in the current manual of survey instructions of the United States Department of the Interior, Bureau of Land Management or by a decree of a Court of Law and/or that the corner points mentioned in lines 3, 4 and 5 above were in conformance with the rules of the Michigan Board of Land Surveyors or by a Decree of a Court of Law; established, re-established, monumented, re-monumented, recovered, found as expressed below:

	A	B	C	D	E	F	G	H	I	J	K	L	I
2	6		5		4		3		2		1		
3													
4	7		8		9		10		11		12		
5													
6	13		14		15		16		17		18		
7													
8	19		20		21		22		23		24		
9													
10	25		26		27		28		29		30		
11													
12	31		32		33		34		35		36		
13													

A. Description of original monument and accessories and/or subsequent restoration:

Set post in 1816 G.L.O. Survey.  
There are no LCRC's recorded at Oakland County.

B. Description of corner evidence found and/or method applied in restoring or reestablishing corner:

No monumentation was recovered at this location. Set and validated corner with monumentation recovered for Lot 59 Huntoon Shores No. 2.


C. Description of monument for corner and accessories established to perpetuate locating the position of the corner:

Set 5/8" iron with Oakland County Remonumentation Brass Cap stamped #24598 in new monument box.

Set Witnesses:

N 86° 54'E 33.89' Set Mag nail south face utility pole.  
N 02° 51'W 116.16' set Mag nail west face 20" Oak.  
N 52°51'W 72.98' Mag nail southwest side 16" Mulberry.  
S 87° 25'W 61.93' Mag nail south side utility pole.

LP  
R

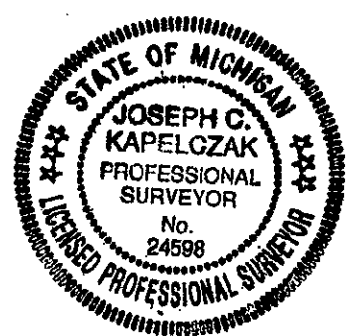

Signed by Joseph C. Kapelczak  
Surveyor's Michigan License No. 24598

Date 12/4/99