

**SURVEY &
REMONUMENTATION**

MAR 14 95 04 1387

LISER 15290 PG 573

OK - T. SMITH

MAY - 1 1995

LAND CORNER RECORDATION CERTIFICATE 7.00 MISC RECORDING CHG - IN HOUSE
\$ 2.00 REMON CHG - IN HOUSE
Filing Requirement of Act 74, Mich. P.A. 1970. 14 MAR 95 9:14 A.M. RECEIPT# 45B

For corners in **COMMISSION**
OAKLAND
(County)

Located in: WATERFORD Corner Code #

PAID RECORDED - OAKLAND COUNTY
LYNN D. ALLEN, CLERK/REGISTER OF DEEDS

- | | | | | | | |
|------------------------------------|---|----------|---|----------|---|------------|
| 1. Public Land Survey | T | <u>3</u> | N | <u>9</u> | E | <u>E-6</u> |
| | T | | R | | | |
| | T | | R | | | |
| | T | | R | | | |
| 2. Property Controlling in Section | S | | T | | R | |
| | S | | T | | R | |
| 3. Miscellaneous Property in Sec. | S | | T | | R | |
| | S | | T | | R | |

Compliance with
ACT 345, P.A. 1990

APPROVED ON: 12-30-94
OAKLAND COUNTY REMONUMENTATION
PEER GROUP COMMITTEE
Register of Deeds Stamp & File Number

4. Lot No. _____, Recorded Plat _____
5. Private Claims _____

A	B	C	D	E	F	G	H	I	J	K	L	M
2	6	5	4	3	2	1						
3												
4	7	8	9	10	11	12						
5												
6	18	17	16	15	14	13						
7												
8	19	20	21	22	23	24						
9												
10	30	29	28	27	26	25						
11												
12	31	32	33	34	35	36						
13												

I, THOMAS M. SMITH, in a field survey on NOVEMBER 29, 19 94, do hereby certify that under requirements of P.A. 74, Michigan P.A. of 1970, the corner points mentioned in lines 1 and 2 above were in conformance with regulations and rules therefore as required in the current manual of survey instructions of the United States Department of the Interior, Bureau of Land Management or by a decree of a Court of Law and/or that the corner points mentioned in lines 3, 4 and 5 above were in conformance with the rules of the Michigan Board of Land Surveyors or by a Decree of a Court of Law; established, re-established, monumented, re-monumented, recovered, found as expressed below:

NOTE: Not more than 4 corners, all in the same town and range, may be recorded on this certificate.


A. Description of original monument and accessories and/or subsequent restoration:

POST, G.L.O. 1817	IRON PIPE ROAD COMMISSION 1963	1/2" PIPE IN MON BOX L.C.R.C. L. 7400 P. 314 HOOTH, 1978
----------------------	--------------------------------------	---

B. Description of corner evidence found and/or method applied in restoring or reestablishing corner:

I FOUND A MDOT DISK ON TOP OF A ROD IN A MONUMENT BOX AT THE INTERSECTION OF AIRPORT ROAD & TUBBS ROAD. I VERIFIED THE CORNER FROM THE WITNESSES IN HOOTH'S L.C.R.C. ALSO A DISTANCE MEASURED SOUTH TO E-7 MATCHED THE 1933 SURVEY OF THE AIRPORT PROPERTY. ALSO THIS CORNER FITS WITH A RIGHT-OF-WAY IRON FOUND NORTHWESTERLY.

7.00
2.00
I.h.ch

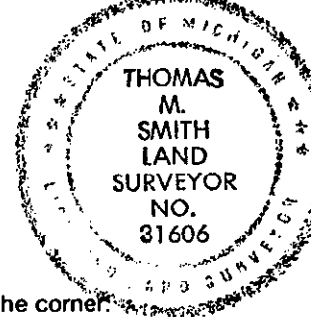

C. Description of monument for corner and accessories established to perpetuate locating the position of the corner:

E-6: I REPLACED THE MDOT BRASS DISC WITH A 5/8" ROD WITH BRASS REMON CAP # 31606
N 45 W. 85.22' to capped iron #31606
S 45 W. 87.42' to capped iron #31606
N 45 E. 74.00' to capped iron #24625
S 55 E. 92.08' to capped iron #31606

THE SELECTED LOCATION IS ACCEPTED BY ME AND IS GENERALLY ACCEPTED BY PROFESSIONAL SUVEYORS AS THE AVAILABLE EVIDENCE OF THE ORIGINAL CORNER.

Signed by [Signature]

Date DECEMBER 19, 1994

31606

Surveyor's Michigan License No. _____