

SURVEY &
REMONUMENTATION

LIBER 15292 PG 377

MAR 15 95 04 1989

OK - T. SMITH

MAY - 1 1995

LAND CORNER RECORDATION CERTIFICATE

Filing Requirement of Act 74, Mich. P.A. 1970

For corners in **COMMISSION**

OAKLAND
(County)

Located In: WATERFORD

Corner Code ##

- | | | |
|------------------------------------|---------------------------|------------|
| 1. Public Land Survey | T <u>3</u> N R <u>9</u> E | <u>G-5</u> |
| | T _____ R _____ | _____ |
| | T _____ R _____ | _____ |
| | T _____ R _____ | _____ |
| 2. Property Controlling in Section | S _____ T _____ R _____ | _____ |
| | S _____ T _____ R _____ | _____ |
| 3. Miscellaneous Property in Sec. | S _____ T _____ R _____ | _____ |
| | S _____ T _____ R _____ | _____ |

\$ 7.00 MISC RECORDING CHG - IN HOUSE
\$ 2.00 REMON CHG - IN HOUSE
15 MAR 95 8:09 A.M. RECEIPT# 88
PAID RECORDED - OAKLAND COUNTY
LYNN D. ALLEN, CLERK/REGISTER OF DEEDS
Compliance with
ACT 345, P.A. 1990

APPROVED ON: 12-30-94
OAKLAND COUNTY REMONUMENTATION
PEER GROUP COMMITTEE

Register of Deeds Stamp & File Number

4. Lot No. _____, Recorded Plat _____
5. Private Claims _____

I, THOMAS M. SMITH, in a field survey on NOVEMBER 29, 19 94, do hereby certify that under requirements of P.A. 74, Michigan P.A. of 1970, the corner points mentioned in lines 1 and 2 above were in conformance with regulations and rules therefore as required in the current manual of survey instructions of the United States Department of the Interior, Bureau of Land Management or by a decree of a Court of Law and/or that the corner points mentioned in lines 3, 4 and 5 above were in conformance with the rules of the Michigan Board of Land Surveyors or by a Decree of a Court of Law, established, re-established, monumented, re-monumented, recovered, found as expressed below:

NOTE: Not more than 4 corners, all in the same town and range, may be recorded on this certificate.

A. Description of original monument and accessories and/or subsequent restoration:

POST, G.L.O. 1817	P.K. NAIL L.C.R.C. L. 7837 P. 053 PAWLACZYK, 1980	P.K. NAIL L.C.R.C. L. 7806 P. 191 WILLIAMS, 1980
----------------------	--	---

B. Description of corner evidence found and/or method applied in restoring or reestablishing corner:

I FOUND A P.K. NAIL AT THE SURFACE OF THE ASPHALT ROAD, BELOW I FOUND A 1/2" RE-ROD, BELOW THE RE-ROD I FOUND A 1" PIPE BELOW THE ASPHALT SURFACE. ALL THREE WERE WITHIN 0.30 FEET OF EACH OTHER. I ACCEPTED THE PIPE AS THE CORNER. THE PIPE WAS THE FURTHEST WEST OF ALL THREE MONUMENTS.

C. Description of monument for corner and accessories established to perpetuate locating the position of the corner:


RE-ROD & PIPE
G-5: I REPLACED THE P.K. NAIL WITH A 5/8" ROD WITH BRASS CAP# 31606 IN A NEW MONUMENT BOX.
NORTH 90.55' to remon tag E. side chinese elm
N 60 E. 93.85' to remon tag N.W. side box elder
N 50 W. 86.05' to remon tag E. side chinese elm
S 55 W. 53.32' to capped iron

THE SELECTED LOCATION IS ACCEPTED BY ME AND IS GENERALLY ACCEPTED BY PROFESSIONAL SURVEYORS AS THE AVAILABLE EVIDENCE OF THE ORIGINAL CORNER.

Signed by [Signature]

Date DECEMBER 19, 1994

Surveyor's Michigan License No. 31606

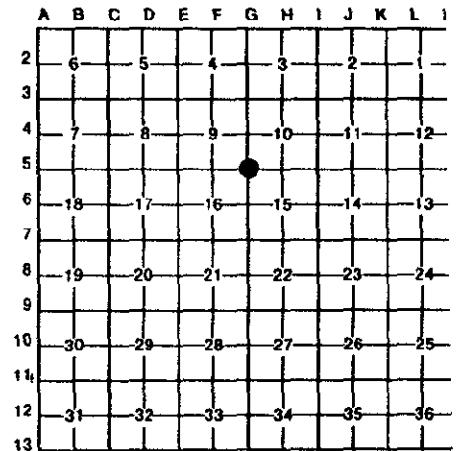

4-10

