

SURVEY & REMONUMENTATION

LIBER 15292 PG 372

MAR 15 95 04 19

MAY - 1 1995

LAND CORNER RECORDATION CERTIFICATE Filing Requirement of Act 74, Mich. P.A. 1970

OK - T. SMITH

For corners in

COMMISSION

OAKLAND

(County)

Located In: WATERFORD

Corner Code #

- 1. Public Land Survey T 3 N R 9E I-9
T R
T R
T R
2. Property Controlling in Section S T R
S T R
3. Miscellaneous Property in Sec. S T R
S T R

\$ 7.00 MISC RECORDING CHG - IN HOUSE
\$ 2.00 REMON CHG - IN HOUSE
15 MAR 95 8:09 A.M. RECEIPT# 88
PAID RECORDED - OAKLAND COUNTY
LYNN D. ALLEN, CLERK/REGISTER OF DEEDS
Compliance with ACT 345, P.A. 1990

APPROVED ON: 12-30-94
OAKLAND COUNTY REMONUMENTATION PEER GROUP COMMITTEE

Register of Deeds Stamp & File Number

- 4. Lot No. , Recorded Plat
5. Private Claims

I, THOMAS M. SMITH, in a field survey on NOVEMBER 26, 19 94, do hereby certify that under requirements of P.A. 74, Michigan P.A. of 1970, the corner points mentioned in lines 1 and 2 above were in conformance with regulations and rules therefore as required in the current manual of survey instructions of the United States Department of the Interior, Bureau of Land Management or by a decree of a Court of Law and/or that the corner points mentioned in lines 3, 4 and 5 above were in conformance with the rules of the Michigan Board of Land Surveyors or by a Decree of a Court of Law, established, re-established, monumented, re-monumented, recovered, found as expressed below:


NOTE: Not more than 4 corners, all in the same town and range, may be recorded on this certificate.

A. Description of original monument and accessories and/or subsequent restoration:

POST, G.L.O. 1817 1/2" CONC. MON IN RETAINING WALL ROAD COMMISSION 1963 CONC. MON. LAKEWOOD FARMS. 1939

B. Description of corner evidence found and/or method applied in restoring or reestablishing corner:

I FOUND THE REMAINS OF A CONCRETE MONUMENT IN A GARDEN AREA OF A BRICK RETAINING WALL. I VERIFIED THE POSITION OF THE MONUMENT FROM THE SURVEY OF W. TITSWORTH.

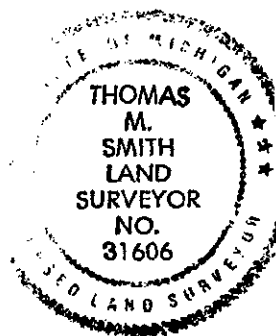

C. Description of monument for corner and accessories established to perpetuate locating the position of the corner:

I-9: I REPLACED BROKEN CONCRETE MON WITH NEW CONCRETE MON. WITH BRASS CAP# 31606
N 10 E. 69.29' to remon tag W. side 10" box elder.
SOUTH 43.36' to remon tag W. side P.P.
S 45 E. 42.69' to HSE. corner.
N 30 E. 56.39' to HSE. corner.

THE SELECTED LOCATION IS ACCEPTED BY ME AND IS GENERALLY ACCEPTED BY PROFESSIONAL SURVEYORS AS THE BEST AVAILABLE EVIDENCE OF THE CORNER.

Signed by

[Handwritten signature]

31606

Date DECEMBER 19, 1994

Surveyor's Michigan License No.