

**SURVEY &
REMONUMENTATION**

LIBER **15290** PG **576**

MAR 14 95 04T390

OK - T. SMITH

MAY - 1 1995

LAND CORNER RECORDATION CERTIFICATE

For corners in **COMMISSION**
OAKLAND
(County)

Filing Requirement of Act 74, Mich. P.A. 1970: 7.00 MISC RECORDING CHG - IN HOUSE
\$ 2.00 REMON CHG - IN HOUSE
14 MAR 95 9:14 A.M. RECEIPT# 45B
PAID RECORDED - OAKLAND COUNTY
LYNN D. ALLEN, CLERK/REGISTER OF DEEDS

	Located In:	WATERFORD		Corner Code #:	
1. Public Land Survey	T	3	N	9	E
	T		R		
	T		R		
	T		R		
2. Property Controlling in Section	S		T		R
	S		T		R
3. Miscellaneous Property in Sec.	S		T		R
	S		T		R

Compliance with
ACT 345, P.A. 1990
APPROVED ON: 12-30-94
OAKLAND COUNTY REMONUMENTATION
PEER GROUP COMMITTEE
Register of Deeds Stamp & File Number

4. Lot No. _____, Recorded Plat _____
5. Private Claims _____

A	B	C	D	E	F	G	H	I	J	K	L	M
2	6	5	4	3	2	1						
3												
4	7	8	9	10	11	12						
5												
6	18	17	16	15	14	13						
7												
8	19	20	21	22	23	24						
9												
10	30	29	28	27	26	25						
11												
12	31	32	33	34	35	36						
13												


I, THOMAS M. SMITH, in a field survey on NOVEMBER 24, 19 94, do hereby certify that under requirements of P.A. 74, Michigan P.A. of 1970, the corner points mentioned in lines 1 and 2 above were in conformance with regulations and rules therefore as required in the current manual of survey instructions of the United States Department of the Interior, Bureau of Land Management or by a decree of a Court of Law and/or that the corner points mentioned in lines 3, 4 and 5 above were in conformance with the rules of the Michigan Board of Land Surveyors or by a Decree of a Court of Law; established, re-established, monumented, re-monumented, recovered, found as expressed below:

NOTE: Not more than 4 corners, all in the same town and range, may be recorded on this certificate.

A. Description of original monument and accessories and/or subsequent restoration:
POST, G.L.O. 1817 IRON PIN ROAD COMMISSION 1963. $\frac{1}{4}$ " IRON PIN L.C.R.C. L. 11266 P. 814 SCHARL, 1990.

B. Description of corner evidence found and/or method applied in restoring or reestablishing corner:
I FOUND $\frac{1}{4}$ " rod in asphalt road, interesection of Lake Angelus Road & Clintonville Road Verified corner by existing Witnesses from L.C.R.C., Liber 11266, Page 814 and from Baldwin Records. the House corner to the S.W. still remains.

7.00
2.00
I h chg

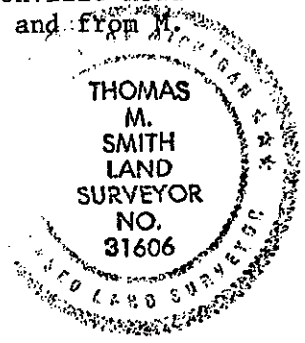

C. Description of monument for corner and accessories established to perpetuate locating the position of the corner:
K-3: I REPLACED THE $\frac{1}{4}$ " ROD WITH $\frac{5}{8}$ " ROD WITH BRASS CAP IN A MONUMENT BOX
N 75 E. 85.31' to remon tag N.W. side 16"
N 45 E. 77.67' to the base of "T" in water (M.H.)
N 45 W. 98.70' to S.E. side of brick church sign.
S 15 W. 50.22' to remon tag W. side 18" elm.

THE SELECTED LOCATION IS ACCEPTED BY ME AND IS ACCEPTED BY PRFESSIONAL SURVYEORS AS THE BEST AVAILABLE EVIDENCE OF THE ORIGINAL CORNER.

Signed by _____ Date DECEMBER 19, 1994
Surveyor's Michigan License No. 31606