

MAY - 1 1995

LAND CORNER RECORDATION CERTIFICATE

OK - T. SMITH

For corners in OAKLAND (County)

COMMISSION

Filing Requirement of Act 74, Mich. P.A. 1970

Located in: WATERFORD Corner Code #

- 1. Public Land Survey T 3 N R 9 E K-5
2. Property Controlling in Section S T R
3. Miscellaneous Property in Sec. S T R

7.00 MISC RECORDING CHG - IN HOUSE
2.00 REMON CHG - IN HOUSE
15 MAR 95 8:07 A.M. RECEIPT# 88
PAID RECORDED - OAKLAND COUNTY
LYNN D. ALLEN, CLERK/REGISTER OF DEEDS
Compliance with ACT 345, P.A. 1990

APPROVED ON: 12-30-94
OAKLAND COUNTY REMONUMENTATION
PEER GROUP COMMITTEE

Register of Deeds Stamp & File Number

- 4. Lot No. Recorded Plat
5. Private Claims

I, THOMAS M. SMITH, in a field survey on NOVEMBER 24, 1994, do hereby certify that under requirements of P.A. 74, Michigan P.A. of 1970, the corner points mentioned in lines 1 and 2 above were in conformance with regulations and rules therefore as required in the current manual of survey instructions of the United States Department of the Interior, Bureau of Land Management or by a decree of a Court of Law and/or that the corner points mentioned in lines 3, 4 and 5 above were in conformance with the rules of the Michigan Board of Land Surveyors or by a Decree of a Court of Law; established, re-established, monumented, re-monumented, recovered, found as expressed below:

NOTE: Not more than 4 corners, all in the same town and range, may be recorded on this certificate.


Grid table with columns A-L and rows 2-13. A dot is marked at row 5, column J.

A. Description of original monument and accessories and/or subsequent restoration:

POST, G.L.O. 1817 1 1/2" PIPE (WELL POINT) L.C.R.C. L. 8751 P. 222 PETRIE, 1984 1" IRON PIPE SILVER BEACH PLAT 1914

B. Description of corner evidence found and/or method applied in restoring or reestablishing corner:

I FOUND A 1" PIPE IN A TREE ROW RUNNING NORTH & SOUTH. A MEASURED DISTANCE SOUTH FITS VERY CLOSE WITH A M. BALDWIN SURVEY. I VERIFIED THE PETRIE L.C.R.C WITH THIS FOUND PIPE.

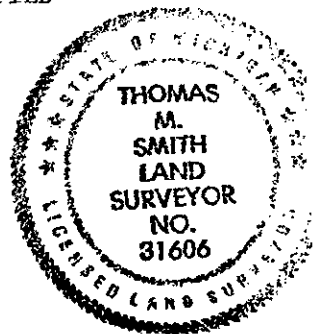

C. Description of monument for corner and accessories established to perpetuate locating the position of the corner:

K-5: I REPLACED THE IRON PIPE WITH A CONCRETE MONUMENT WITH BRASS CAP #31606.
N 40 E. 33.04' to remon tag W. side twin 6" birch.
SOUTH 11.17' to remon tag E. side 24" maple.
N 35 W. 62.54' to remon tag S.W. side twin elm.
S 45 W. 55.05' to remon tag W. side 36" oak.

THE SELECTED LOCATION IS ACCEPTED BY ME AND IS GENERALLY ACCEPTED BY PROFESSIONAL SURVEYORS AS THE BEST AVAILABLE EVIDENCE OF THE ORIGINAL CORNER.

Signed by [Signature]

Date DECEMBER 19, 1994

Surveyor's Michigan License No. 31606