SURVEY & REMONUMENTATION

MAR 15 95 04 1972

LIBER 15292 PG 360

OK - T. SMITH

MAY - 1 1995

COMMISSION

LAND CORNER RECORDATION CERTIFICATE

Filing Requirement of Act 74, Mich. P.A. 1970

$ 7.00 MISC RECORDING CHG - IN HOUSE
$ 2.00 REMON CHG - IN HOUSE
15 MAR 95 8:07 A.M. RECEIPT# 88
PAID RECORDED - OAKLAND COUNTY
LYNN D. ALLEN, CLERK/REGISTER OF DEEDS

For corners in OAKLAND (County) Located In: WATERFORD Corner Code ##

1. Public Land Survey T 3 N R 9 E K-6
   T ___ R ___
   T ___ R ___
   T ___ R ___
2. Property Controlling S ___ T ___ R ___
   in Section S ___ T ___ R ___
3. Miscellaneous S ___ T ___ R ___
   Property in Sec. S ___ T ___ R ___

Compliance with ACT 345, P.A. 1990

APPROVED ON: 12-30-94
OAKLAND COUNTY REMONUMENTATION PEER GROUP COMMITTEE

Register of Deeds Stamp & File Number

4. Lot No. _____, Recorded Plat _____
5. Private Claims _____

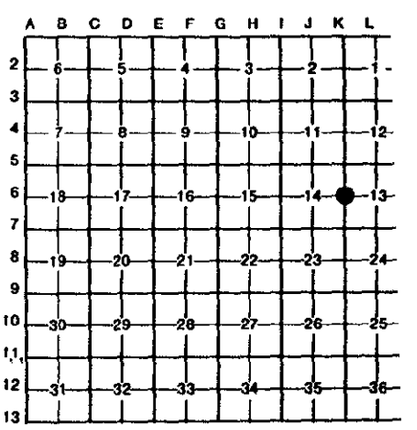

I, THOMAS M. SMITH, in a field survey on NOVEMBER 24, 19 94, do hereby certify that under requirements of P.A. 74, Michigan P.A. of 1970, the corner points mentioned in lines 1 and 2 above were in conformance with regulations and rules therefore as required in the current manual of survey instructions of the United States Department of the Interior, Bureau of Land Management or by a decree of a Court of Law and/or that the corner points mentioned in lines 3, 4 and 5 above were in conformance with the rules of the Michigan Board of Land Surveyors or by a Decree of a Court of Law; established, re-established, monumented, re-monumented, recovered, found as expressed below:

NOTE: Not more than 4 corners, all in the same town and range, may be recorded on this certificate.

A. Description of original monument and accessories and/or subsequent restoration:

POST G.L.O. 1817 — REINFORCED STEEL ROAD COMMISSION 1963 — ½" IRON IN MON. BOX L.C.R.C. L. 8751 P. 223 PETRIE, 1984

B. Description of corner evidence found and/or method applied in restoring or reestablishing corner:

I FOUND A ½" IRON ROD IN A MONUMENT BOX IN THE CENTERLINE OF SCOTT LAKE ROAD.
I VERIFIED CORNER FROM THE PETRIE L.C.R.C. AND ROAD COMMISSION TIES.
A MEASURED DISTANCE NORTH TO K-5 HITS EXTREMELY CLOSE TO A M. BALDWIN SURVEY.

THOMAS M. SMITH LAND SURVEYOR NO. 31606 LICENSED LAND SURVEYOR

C. Description of monument for corner and accessories established to perpetuate locating the position of the corner:

K-6: I REPLACED ½" ROD WITH 5/8" ROD WITH BRASS CAP #31606
N 45 W. 76.57' to remon tag E. side 14" oak.
WEST 61.19' to remon tag N. side 36" walnut.
N 15 E. 84.57' to remon tag S.E. side 9" oak.
S 50 E. 50.85' to remon tag N. side 10" pine.

THE SELECTED LOCATION IS ACCEPTED BY ME AND IS ACCEPTED BY PROFESSIONAL SERVEYORS AS THE BEST AVAILABLE EVIDENCE OF THE ORIGINAL CORNER.

Signed by _____ Date DECEMBER 19, 1994

Surveyor's Michigan License No. 31606

FORM APPROVED BY MICHIGAN STATE BOARD OF LAND SURVEYORS, JAN. 28, 1971
REVISED MAY 14, 1975
REVISED JAN., 1983