

MAR 15 1970

MAR 15 1970

SURVEY & REMONUMENTATION

LIBER 15292 PG 358

LAND CORNER RECORDATION CERTIFICATE
Filing Requirement of Act 74, Mich. P.A. 1970

OK - T. SMITH

MAY - 1 1995

For corners in

OAKLAND

(County)

COMMISSION

Located In: WATERFORD

Corner Code ≠

\$ 7.00 MISC RECORDING CHG - IN HOUSE
\$ 2.00 REMON CHG - IN HOUSE
15 MAR 95 8:07 A.M. RECEIPT# 88
PAID RECORDED - OAKLAND COUNTY
LYNN D. ALLEN, CLERK/REGISTER OF DEEDS
Compliance with
ACT 345, P.A. 1990

APPROVED ON: 12-30-94
OAKLAND COUNTY REMONUMENTATION
PEER GROUP COMMITTEE
Register of Deeds Stamp & File Number

- 1. Public Land Survey T 3 N R 9E K-9
T _____ R _____
T _____ R _____
T _____ R _____
- 2. Property Controlling S _____ T _____ R _____
in Section S _____ T _____ R _____
- 3. Miscellaneous S _____ T _____ R _____
Property in Sec. S _____ T _____ R _____

- 4. Lot No. _____, Recorded Plat _____
- 5. Private Claims _____

I, THOMAS M. SMITH, in a field survey on NOVEMBER 24, 19 94, do hereby certify that under requirements of P.A. 74, Michigan P.A. of 1970, the corner points mentioned in lines 1 and 2 above were in conformance with regulations and rules therefore as required in the current manual of survey instructions of the United States Department of the Interior, Bureau of Land Management or by a decree of a Court of Law and/or that the corner points mentioned in lines 3, 4 and 5 above were in conformance with the rules of the Michigan Board of Land Surveyors or by a Decree of a Court of Law; established, re-established, monumented, re-monumented, recovered, found as expressed below:

NOTE: Not more than 4 corners, all in the same town and range, may be recorded on this certificate.


A. Description of original monument and accessories and/or subsequent restoration:

POST, G.L.O. 1817	IRON BAR IN MON. BOX. L.C.R.C. L. 5760 P. 734 CARLSON, 1971	IRON IN MON. BOX. L.C.R.C. L. 13427 P. 024 VAN HAVERMAAT, 1993
----------------------	--	---

	A	B	C	D	E	F	G	H	I	J	K	L	M
2	6		5		4		3		2		1		
3													
4	7		8		9		10		11		12		
5													
6	18		17		16		15		14		13		
7													
8	19		20		21		22		23		24		
9													
10	30		29		28		27		26		25		
11													
12	31		32		33		34		35		36		
13													

B. Description of corner evidence found and/or method applied in restoring or reestablishing corner:

I FOUND A 1/2" ROD IN A MONUMENT BOX AT THE INTERSECTION OF SCOTT LAKE & PONTIAC LAKE ROADS. I VERIFIED CORNER FROM BOTH L.C.R.C FROM ABOVE. I MEASURED NORTH & SOUTH AND VERIFIED PLAT DISTANCES VERY CLOSELY.

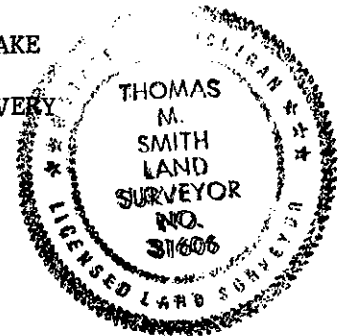

C. Description of monument for corner and accessories established to perpetuate locating the position of the corner:

K-9: I REPLACED THE IRON ROD WITH A 5/8" ROD WITH A BRASS CAP #31606
N 60 W. 79.30' to remon tag S. side 7" pine.
N 20 E. 116.45' to remon tag S.W. side 14" pine.
S 55 E. 80.20' to remon tag S.W. side 6" elm.

THE SELECTED LOCATION IS ACCOPTED BY ME AND IS GENERALLY ACCEPTED BY PROFESSIONAL SURVEYORS AS THE BEST AVAILABLE EVIDENCE OF THE ORIGINAL CORNER.

Signed by [Signature]
Surveyor's Michigan License No. 31606

Date DECEMBER 19, 1994