

**SURVEY &
REMONUMENTATION**

MAY - 1 1995

LIBER 15292 PG 357

MAR 15 95 04 1969
OK - T. SMITH

LAND CORNER RECORDATION CERTIFICATE
COMMISSION Filing Requirement of Act 74, Mich. P.A. 1970

7.00 MISC RECORDING CHG - IN HOUSE
2.00 REMON CHG - IN HOUSE
15 MAR 95 8:06 A.M. RECEIPT# 88
PAID RECORDED - OAKLAND COUNTY
LYNN D. ALLEN, CLERK/REGISTER OF DEEDS

For corners in
OAKLAND
(County)

Located In: WATERFORD Corner Code ##

- 1. Public Land Survey T 3 N R 9 E K-10
 T _____ R _____
 T _____ R _____
 T _____ R _____
- 2. Property Controlling S _____ T _____ R _____
 in Section S _____ T _____ R _____
- 3. Miscellaneous S _____ T _____ R _____
 Property in Sec. S _____ T _____ R _____
- 4. Lot No. _____, Recorded Plat _____
- 5. Private Claims _____

Compliance with
ACT 345, P.A. 1990
APPROVED ON: 12-30-94
OAKLAND COUNTY REMONUMENTATION
PEER GROUP COMMITTEE
Register of Deeds Stamp & File Number

I, THOMAS M. SMITH, in a field survey on NOVEMBER 24, 19 94, do hereby certify that under requirements of P.A. 74, Michigan P.A. of 1970, the corner points mentioned in lines 1 and 2 above were in conformance with regulations and rules therefore as required in the current manual of survey instructions of the United States Department of the Interior, Bureau of Land Management or by a decree of a Court of Law and/or that the corner points mentioned in lines 3, 4 and 5 above were in conformance with the rules of the Michigan Board of Land Surveyors or by a Decree of a Court of Law; established, re-established, monumented, re-monumented, recovered, found as expressed below:

NOTE: Not more than 4 corners, all in the same town and range, may be recorded on this certificate.


	A	B	C	D	E	F	G	H	I	J	K	L	M
2	6	5	4	3	2	1							
3													
4	7	8	9	10	11	12							
5													
6	18	17	16	15	14	13							
7													
8	19	20	21	22	23	24							
9													
10	30	29	28	27	26	25							
11													
12	31	32	33	34	35	36							
13													

A. Description of original monument and accessories and/or subsequent restoration:

POST, G.L.O. 1817	IRON AXLE ROAD COMMISSION 1963	R.R. SPIKE IN MON. BOX L.C.R.C. L.6748 P. 606 stonerock, 1976
----------------------	--------------------------------------	--

B. Description of corner evidence found and/or method applied in restoring or reestablishing corner:

I FOUND A 1/2" ROD IN A MONUMENT BOX. I VERIFIED CORNER FROM STONEROCK L.C.R.C. I ALSO MEASURED NORTH TO VERIFIED CORNER FROM ADJACENT PLATTED DIMENSIONS. I FIT A ROAD COMMISSION TIE S.E"LY TO THE HOUSE CORNER.

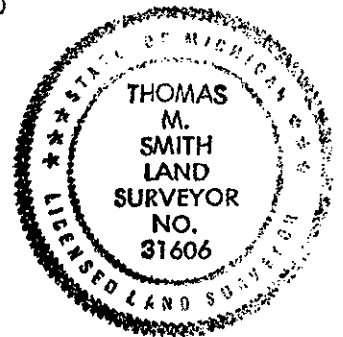

C. Description of monument for corner and accessories established to perpetuate locating the position of the corner:

K-10: REPLACED IRON ROD WITH A 5/8" ROD WITH BRASS CAP #31606
N 35 W. 90.75' to remon tag S.E. side 14" maple.
S 45 W. 111.80' to remon tag S.E side 18" pine.
S 50 E. 82.20' to remon tag S.W. side 5" pine
N 45 E. 89.03' to capped iron

THE SELECTED LOCATION IS ACCEPTED BY ME AND IS GENERALLY ACCEPTED BY PROFESSIONAL SERVEYORS AS THE BEST AVAILABLE EVIDNENCE OF THE ORIGINAL CORNER.

Signed by [Signature] Date DECEMBER 19, 1994
Surveyor's Michigan License No. 31606