

**SURVEY &
REMONUMENTATION**

Mar 15 95 04 1966

MAY - 1 1995

LIBER **15292** PG. **354**
LAND CORNER RECORDATION CERTIFICATE
Filing Requirement of Act 74, Mich. P.A. 1970

OK - T. SMITH

For corners in **COMMISSION**
OAKLAND
(County)

Located in: WATERFORD Corner Code #

- | | | |
|------------------------------------|--------------------------|------------|
| 1. Public Land Survey | T <u>3</u> N R <u>9E</u> | <u>L-9</u> |
| | T _____ R _____ | _____ |
| | T _____ R _____ | _____ |
| | T _____ R _____ | _____ |
| 2. Property Controlling in Section | S _____ T _____ R _____ | _____ |
| | S _____ T _____ R _____ | _____ |
| 3. Miscellaneous Property in Sec. | S _____ T _____ R _____ | _____ |
| | S _____ T _____ R _____ | _____ |

\$ 7.00 MISC RECORDING CHG - IN HOUSE
\$ 2.00 REMON CHG - IN HOUSE
15 MAR 95 8:06 A.M. RECEIPT# 88
PAID RECORDED - OAKLAND COUNTY
LYNN D. ALLEN, CLERK, REGISTER OF DEEDS
ACT 345, P.A. 1990

APPROVED ON: 12-30-94
OAKLAND COUNTY REMONUMENTATION
PEER GROUP COMMITTEE
Register of Deeds Stamp & File Number

4. Lot No. _____, Recorded Plat _____
5. Private Claims _____

I, THOMAS M. SMITH, in a field survey on NOVEMBER 22, 19 94, do hereby certify that under requirements of P.A. 74, Michigan P.A. of 1970, the corner points mentioned in lines 1 and 2 above were in conformance with regulations and rules therefore as required in the current manual of survey instructions of the United States Department of the Interior, Bureau of Land Management or by a decree of a Court of Law and/or that the corner points mentioned in lines 3, 4 and 5 above were in conformance with the rules of the Michigan Board of Land Surveyors or by a Decree of a Court of Law; established, re-established, monumented, re-monumented, recovered, found as expressed below:


NOTE: Not more than 4 corners, all in the same town and range, may be recorded on this certificate.

A. Description of original monument and accessories and/or subsequent restoration:

POST, G.L.O. $\frac{1}{2}$ " STEEL BAR
1817 L.C.R.C.
L. 5760 P. 734
CARLSON, 1971

B. Description of corner evidence found and/or method applied in restoring or reestablishing corner:

I FOUND A IRON ROD APPROX. 1 FOOT WEST OF A NORTH-SOUTH BRICK WALL. I VERIFIED THE CORNER FROM THE L.C.R.C. ABOVE AND WITH ADJACENT PLATTED LOTS IN BIRDSLAND SUBDIVISION.

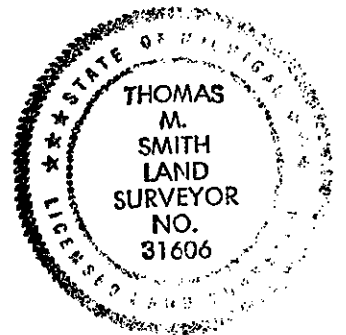

C. Description of monument for corner and accessories established to perpetuate locating the position of the corner:

L-9: I REPLACED STEEL ROD WITH A CONCRETE MONUMENT AND BRASS CAP# 31606
NORTH 59.00' to remon tag E. side 14" tree
SOUTH 33.70 to remon tag E. side 12" tree
WEST 85.70' to remon tag 18" walnut
S 75 W. 40.00' to remon tag 12" twin tree

THE SELESTED LOCATION IS ACCEPTED BY NE AND IS GENERALLY ACCEPTED BY PROFESSIONAL SERVEYORS AS THE BEST AVAILABLE EVIDENCE OF THE ORIGINAL CORNER.

Signed by [Signature]
Surveyor's Michigan License No. 31606

Date DECEMBER 19, 1994

	A	B	C	D	E	F	G	H	I	J	K	L	M
2	6	5	4	3	2	1							
3													
4	7	8	9	10	11	12							
5													
6	18	17	16	15	14	13							
7													
8	19	20	21	22	23	24							
9													
10	30	29	28	27	26	25							
11													
12	31	32	33	34	35	36							
13													

Handwritten initials/signature