

MAY 24 2000

LIBER 21146 080

SECTION

LAND CORNER RECORDATION CERTIFICATE
Filing Requirement of Act 74, Mich. P.A. 1970

59631

For corners in

<u>Oakland</u> (county)	Located In:	Corner Code #
	Waterford Township	
1. Public Land Survey	T <u>3N</u> R <u>9E</u>	<u>M-4</u>
	T_____ R_____	_____
	T_____ R_____	_____
	T_____ R_____	_____
2. Property Controlling in Section	S_____ T_____	_____
	S_____ T_____	_____
3. Miscellaneous Property in Sec.	S_____ T_____	_____
	S_____ T_____	_____

LIBER 21146 PAGE 80
 \$9.00 MISC RECORDING
 \$2.00 REMONUMENTATION
 02/29/2000 10:58:27 A.M. RECEIPT# 16518
 PAID RECORDED - OAKLAND COUNTY
 G. WILLIAM CADDELL, CLERK/REGISTER OF DEEDS

RECEIVED ON: 11-24-99 JH
 OAKLAND COUNTY REGISTER OF DEEDS
 REGISTER OF DEEDS STAMP & FILE NUMBER

4. Lot No. _____, Recorded Plat _____

5. Private Claims _____

I, Joseph C. Kapelczak, in a field survey on March 25, 1999, do hereby certify that under requirements of P.A. 74, Michigan P.A. of 1970, the corner points mentioned in lines 1 and 2 above were in conformance with regulations and rules therefore as required in the current manual of survey instructions of the United States Department of the Interior, Bureau of Land Management or by a decree of a Court of Law and/or that the corner points mentioned in lines 3, 4 and 5 above were in conformance with the rules of the Michigan Board of Land Surveyors or by a Decree of a Court of Law; established, re-established, monumented, re-monumented, recovered, found as expressed below:

A	B	C	D	E	F	G	H	I	J	K	L	N
2	6	5	4	3	2	1						
3												
4	7	8	9	10	11	12						
5												
6	16	17	18	15	14	13						
7												
8	19	20	21	22	23	24						
9												
10	30	29	28	27	26	25						
11												
12	31	32	33	34	35	36						
13												

A. Description of original monument and accessories and/or subsequent restoration:

Set post in 1816 G.L.O. Survey.

There are no LCRC's recorded at Oakland County.

B. Description of corner evidence found and/or method applied in restoring or reestablishing corner:


Recovered a 1/2" iron at this location. Also recovered a 5/8" pipe 0.33' south and 1.26' west of the 1/2" iron. We also recovered irons and monuments within Lot 71 of Silver Lake Estates No. 4 which we believe validates the 1/2" iron as M-4 of Waterford Township. The 5/8" iron pipe falls exactly at the midpoint between M-3 and M-5 and I believe someone set this iron at that midpoint and disregarded the 1/2" iron as being M-4.

C. Description of monument for corner and accessories established to perpetuate locating the position of the corner:

Set concrete monument with Oakland County Remonumentation Brass Cap stamped #24598.

- S 62°11'08"W 84.89' Found Mag nail with tag #21276 south side of 21" Cottonwood.
- S 14°34'16"W 20.85' Found Mag nail with tag #21276 east side 36" Willow.
- S 88°43'41"E 49.01' Found Mag nail with tag #21276 south side twin 14" Cherry.
- N 20°01'00"W 67.20' Found Mag nail with tag #21276 east side old power pole.

JH
R

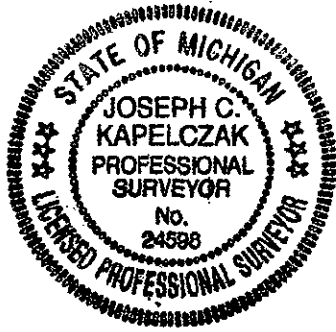

Signed by Joseph C. Kapelczak Date 12/22/99
 Surveyor's Michigan License No. 24598