

SURVEY & REMONUMENTATION

LIBER 15292 PG 370

Mar 15 95 04 1982
OK - T. SMITH

MAY - 1 1995

LAND CORNER RECORDATION CERTIFICATE

For corners in **COMMISSION**
OAKLAND (County)

Filing Requirement of Act 74, Mich. P.A. 1976 7.00 MISC RECORDING CHG - IN HOUSE

\$ 2.00 REMON CHG - IN HOUSE
15 MAR 95 8:08 A.M. RECEIPT# 88
PAID RECORDED - OAKLAND COUNTY
LYNN D. ALLEN, CLERK/REGISTER OF DEEDS

1. Public Land Survey	T	<u>3</u>	N	R	<u>9</u>	E	M-6
	T	_____	R	_____	_____	_____	_____
	T	_____	R	_____	_____	_____	_____
	T	_____	R	_____	_____	_____	_____
2. Property Controlling in Section	S	_____	T	_____	R	_____	_____
	S	_____	T	_____	R	_____	_____
3. Miscellaneous Property in Sec.	S	_____	T	_____	R	_____	_____
	S	_____	T	_____	R	_____	_____

Compliance with ACT 345, P.A. 1990

APPROVED ON: 12-30-94
OAKLAND COUNTY REMONUMENTATION PEER GROUP COMMITTEE

Register of Deeds Stamp & File Number

4. Lot No. _____, Recorded Plat _____
5. Private Claims _____

I, THOMAS M. SMITH, in a field survey on NOVEMBER 22, 19 94, do hereby certify that under requirements of P.A. 74, Michigan P.A. of 1970, the corner points mentioned in lines 1 and 2 above were in conformance with regulations and rules therefore as required in the current manual of survey instructions of the United States Department of the Interior, Bureau of Land Management or by a decree of a Court of Law and/or that the corner points mentioned in lines 3, 4 and 5 above were in conformance with the rules of the Michigan Board of Land Surveyors or by a Decree of a Court of Law; established, re-established, monumented, re-monumented, recovered, found as expressed below:

	A	B	C	D	E	F	G	H	I	J	K	L
2	6	5	4	3	2	1						
3												
4	7	8	9	10	11	12						
5												
6	18	17	16	15	14	13						
7												
8	19	20	21	22	23	24						
9												
10	30	29	28	27	26	25						
11												
12	31	32	33	34	35	36						
13												


NOTE: Not more than 4 corners, all in the same town and range, may be recorded on this certificate.

A. Description of original monument and accessories and/or subsequent restoration:

POST, G.L.O. 1817	1/2" IRON PIPE ROAD COMMISSION 1963	3/4" PIPE L.C.R.C. L. 8627 P.087 PETRIE, 1984	3/4" PIPE L.C.R.C. L. 10319 P.632 STONEROCK, 1988
----------------------	---	--	--

B. Description of corner evidence found and/or method applied in restoring or reestablishing corner:

I FOUND A 3/4" PIPE. THIS CORNER REPRESENTS THE PLAT CORNER OF OAKWOOD MANOR SUBDIVISION. I VERIFIED THE CORNER POSITION FROM THE L.C.R.C'S.

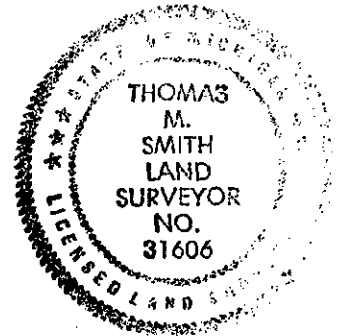

C. Description of monument for corner and accessories established to perpetuate locating the position of the corner:

M-6: I REPLACED THE 3/4" PIPE WITH A CONCRETE MONUMENT WITH BRASS CAP# 31606
N 70 W. 47.65' to remon tag S. side 5" pine.
N 25 E. 112.55' to remon tag S.E. side 8" tree.
EAST 41.82' to remon tag N. side 7" tree.
S 60 E. 72.82' to remon tag S.W. side 12" tree.

THE SELECTED LOCATION IS ACCEPTED BY ME AND ACCEPTED BY PROFESSIONAL SURVEYORS AS THE BEST AVAILABLE EVIDENCE OF THE ORIGINAL CORNER.

Signed by [Signature]

Date DECEMBER 19, 1994

Surveyor's Michigan License No. 31606