

**SURVEY & REMONUMENTATION**

LIBER. **15292** PG. **369**

MAR 15 1995 04 19 81

MAY - 1 1995

OK - T. SMITH

**COMMISSION**

**LAND CORNER RECORDATION CERTIFICATE**

Filing Requirement of Act 74, Mich. P.A. 1970 7.00 MISC RECORDING CHG - IN HOUSE

For corners in

OAKLAND

(County)

Located in: WATERFORD

Corner Code #

- |                                    |   |          |   |   |          |   |     |
|------------------------------------|---|----------|---|---|----------|---|-----|
| 1. Public Land Survey              | T | <u>3</u> | N | R | <u>9</u> | E | M-7 |
|                                    | T |          | R |   |          |   |     |
|                                    | T |          | R |   |          |   |     |
|                                    | T |          | R |   |          |   |     |
| 2. Property Controlling in Section | S |          | T |   | R        |   |     |
|                                    | S |          | T |   | R        |   |     |
| 3. Miscellaneous Property in Sec.  | S |          | T |   | R        |   |     |
|                                    | S |          | T |   | R        |   |     |

\$ 2.00 REMON CHG - IN HOUSE  
 15 MAR 95 8:08 A.M. RECEIPT# 88  
 PAID RECORDED - OAKLAND COUNTY  
 LYNN D. ALLEN, CLERK/REGISTER OF DEEDS

Compliance with ACT 345, P.A. 1990

APPROVED ON: 12-30-94  
 OAKLAND COUNTY REMONUMENTATION PEER GROUP COMMITTEE

Register of Deeds Stamp & File Number

4. Lot No. \_\_\_\_\_, Recorded Plat \_\_\_\_\_  
 5. Private Claims \_\_\_\_\_

I, THOMAS M. SMITH, in a field survey on NOVEMBER 22, 19 94, do hereby certify that under requirements of P.A. 74, Michigan P.A. of 1970, the corner points mentioned in lines 1 and 2 above were in conformance with regulations and rules therefore as required in the current manual of survey instructions of the United States Department of the Interior, Bureau of Land Management or by a decree of a Court of Law and/or that the corner points mentioned in lines 3, 4 and 5 above were in conformance with the rules of the Michigan Board of Land Surveyors or by a Decree of a Court of Law; established, re-established, monumented, re-monumented, recovered, found as expressed below:

**NOTE: Not more than 4 corners, all in the same town and range, may be recorded on this certificate.**


	A	B	C	D	E	F	G	H	I	J	K	L	M
2	6		5		4		3		2		1		
3													
4	7		8		9		10		11		12		
5													
6	18		17		16		15		14		13		
7													
8	19		20		21		22		23		24		
9													
10	30		29		28		27		26		25		
11													
12	31		32		33		34		35		36		
13													

A. Description of original monument and accessories and/or subsequent restoration:

POST, G.L.O.	1" STEEL PIPE	3/4" PIPE
1817	ROAD COMMISSION	L.C.R.C.
	1963	L. 10319 P. 632
		STONEROCK, 1988

B. Description of corner evidence found and/or method applied in restoring or reestablishing corner:

I FOUND A 3/4" PIPE IN THE CENTERLINE AREA OF WEST ROAD. A CEMETERY FENCE RUNS WEST FROM THE CORNER. THIS CORNER WAS VERIFIED BY USING THE STONEROCK, L.C.R.C.

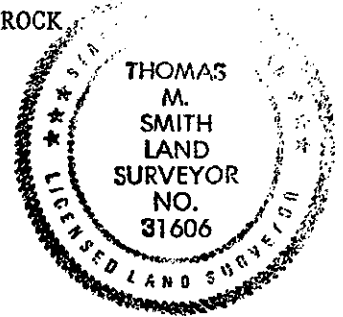

C. Description of monument for corner and accessories established to perpetuate locating the position of the corner:

M-7: I REPLACED THE 3/4" PIPE WITH A 5/8" ROD WITH A BRASS CAP #31606  
 N 40 W. 76.80' to Center line fence post.  
 EAST 30.95' to west edge of fence.  
 S 80 W. 26.80' to remon tag S. side 36" maple.  
 S 15 W. 52.58' to remon tag S.W. side 17" maple.

THE SELECTED LOCATION IS ACCEPTED BY ME AND IS GENERALLY ACCEPTED BY PROFESSIONAL SURVEYORS AS THE BEST AVAILABLE EVIDENCE OF THE ORIGINAL CORNER.

Signed by [Signature]

Date DECEMBER 19, 1994

Surveyor's Michigan License No. 31606