

SURVEY & REMONUMENTATION

MAY - 1 1995

LIBER 15292 PC 364

MAR 15 95 04 1976

OK - T. SMITH

COMMISSION

LAND CORNER RECORDATION CERTIFICATE

Filing Requirement of Act 74, Mich. P.A. 1970

For corners in

OAKLAND

(County)

Located In: WATERFORD

Corner Code ##

\$ 7.00 MISC RECORDING CHG - IN HOUSE
 \$ 2.00 REMON CHG - IN HOUSE
 15 MAR 95 8:07 A.M. RECEIPT# 88
 PAID RECORDED - OAKLAND COUNTY
 LYNN D. ALLEN, CLERK/REGISTER OF DEEDS

Compliance with
 ACT 345, P.A. 1990

APPROVED ON: 12-30-94
 OAKLAND COUNTY REMONUMENTATION
 PEER GROUP COMMITTEE

Register of Deeds Stamp & File Number

- | | | | | | | |
|------------------------------------|---|----------|---|----------|---|------|
| 1. Public Land Survey | T | <u>3</u> | N | <u>9</u> | E | M-13 |
| | T | | R | | | |
| | T | | R | | | |
| | T | | R | | | |
| 2. Property Controlling in Section | S | | T | | R | |
| | S | | T | | R | |
| 3. Miscellaneous Property in Sec. | S | | T | | R | |
| | S | | T | | R | |

4. Lot No. _____, Recorded Plat _____
 5. Private Claims _____

I, THOMAS M. SMITH, in a field survey on NOVEMBER 22, 19 94, do hereby certify that under requirements of P.A. 74, Michigan P.A. of 1970, the corner points mentioned in lines 1 and 2 above were in conformance with regulations and rules therefore as required in the current manual of survey instructions of the United States Department of the Interior, Bureau of Land Management or by a decree of a Court of Law and/or that the corner points mentioned in lines 3, 4 and 5 above were in conformance with the rules of the Michigan Board of Land Surveyors or by a Decree of a Court of Law; established, re-established, monumented, re-monumented, recovered, found as expressed below:


NOTE: Not more than 4 corners, all in the same town and range, may be recorded on this certificate.

A. Description of original monument and accessories and/or subsequent restoration:

POST, G.L.O. 1817	MON AT FENCE CORNER L.C.R.C. L. 12879 P. 182 SCHARL, 1992	1" MON SYLVAN LAKE SUB 1913
----------------------	--	-----------------------------------

B. Description of corner evidence found and/or method applied in restoring or reestablishing corner:

I FOUND A CONCRETE MONUMENT FOR THIS CORNER. I MEASURED AND VERIFIED THIS MONUMENT WITH THE ADJACENT PLATTED LOTS. I DO NOT BELIEVE THIS IS THE ORIGINAL PLATTED MONUMENT FROM THE SYLVAN LAKE SUB. NO. 3 plat.

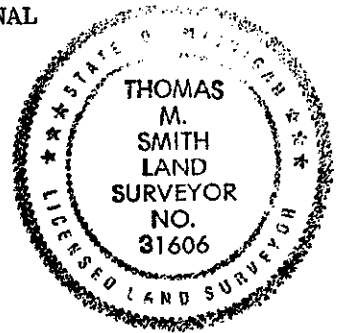

C. Description of monument for corner and accessories established to perpetuate locating the position of the corner:

M-13: I PLACED A REMON BRASS CAP #31606 ON THE EXISTING CONCRETE MONUMENT.
 N 85 W. 39.50' to remon tag N.E. side 20" maple.
 S 85 W. 80.35' to N.E foundation corner of HSE.
 N 30 W. 93.90' to remon tag N.E. side 6" pine.

THE SELECTED LOCATION IS ACCEPTED BY ME AND IS GENERALLY ACCEPTED BY PROFESSIONAL SURVEYORS AS THE BEST AVAILABLE EVIDENCE OF THE ORIGINAL CORNER.

Signed by [Signature]

Date DECEMBER 19, 1994

Surveyor's Michigan License No. 31606