

LAND CORNER RECORDATION CERTIFICATE
Filing Requirement of Act 74, Mich. P.A. 1970

206160

For corners in

OAKLAND

(County)

Located in: PONTIAC Corner Code # A-2
TWP.

LIBER 20101 PAGE 720
\$7.00 MISC RECORDING
\$2.00 REMONUMENTATION
06/10/1999 12:32:43 P.M. RECEIPT# 4151
PAID RECORDED - OAKLAND COUNTY
G. WILLIAM CADDELL, CLERK/REGISTER OF I

1. Public Land Survey

T 3N R 10E A-2

T R

T R

T R

2. Property Controlling
In Section

S T R BEL SURVEY &
S T R REGISTRATION

3. Miscellaneous
Property in Sec.

S T R MAR 21 2000
S T R

Compliance with
ACT 345, P.A. 1990

APPROVED ON: 4-4-99 JJ
OAKLAND COUNTY REMONUMENTATION
PEER GROUP COMMITTEE

Register of Deeds Stamp & File Number

SECTION

4. Lot No. _____, Recorded Plat _____

5. Private Claims _____


RAYMOND J. McCOY, in a field survey on Mar. 17, 1999 do hereby state that under requirements of P.A. 74, Michigan P.A. of 1970, the corner points mentioned in lines 1 and 2 above were in conformance with regulations and rules therefore as required in the current manual of survey instructions of the United States Department of the Interior, Bureau of Land Management or by a decree of a Court of Law and/or that the corner points mentioned in lines 3, 4 and 5 above were in conformance with the rules of the Michigan Board of Land Surveyors or by a Decree of a Court of Law; established, re-established, monumented, recovered, found as expressed below:

NOTE: Not more than 2 corners, all in the same town and range, may be recorded on this certificate.

A. Description of original monument and accessories and/or subsequent restoration:

WAMPLER, D.S., SET POST.
THERE ARE NO. L.C.R.C.'S RECORDED.

	A	B	C	D	E	F	G	H	I	J	K	L	M
1													
2	6		5		4		3		2		1		
3													
4	7		8		9		10		11		12		
5													
6	18		17		16		15		14		13		
7													
8	19		20		21		22		23		24		
9													
10	30		29		28		27		26		25		
11													
12	31		32		33		34		35		36		
13													

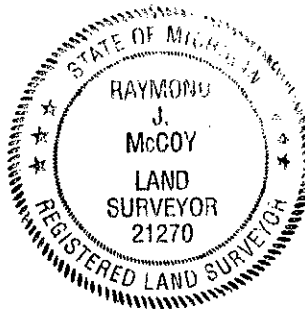

B. Description of corner evidence found and/or method applied in restoring or reestablishing corner:

No corner was found. Corner was set by measuring 41.56 Chains southerly along the East Line of Waterford Twp. (M-1 to M-2) from the N.W. corner of Section 6, as shown on County Survey Records(1854).

State Plane Coordinates N 438447.7143
E 13402391.0730

C. Description of monument for corner and accessories established to perpetuate locating the position of the corner:

Set a concrete monument, consisting of a 1/2" iron rod encased in a 4" diameter concrete cylinder 36" long with a 2" diameter brass disk stamped Oakland County Remonumentation P.S. #21270.

Witness:

- N 04° W, 19.24' Set O.C.R.T. #21270, East face 24" Oak.
- Due West, 8.23' Set O.C.R.T. #21270, North face Power Pole.
- S 04° W, 16.30' Set O.C.R.T. #21270, East face 18" Oak.
- Due East, 62.05' Set O.C.R.T. #21270, North face 12" Oak.

THE SELECTED LOCATION IS ACCEPTED BY ME AND IS GENERALLY ACCEPTED BY PROFESSIONAL SURVEYORS AS THE BEST AVAILABLE EVIDENCE OF THE POSITION OF THE ORIGINAL CORNER.

Signed by Raymond J. McCoy
Surveyor's Michigan License No. 21270

Date June 4, 99