

LIBER 20101 PG 722

LAND CORNER RECORDATION CERTIFICATE  
Filing Requirement of Act 74, Mich. P.A. 1970

206162

LIBER 20101 PAGE 722  
\$7.00 MISC RECORDING  
\$2.00 REMONUMENTATION  
06/10/1999 12:32:43 P.M. RECEIPT# 41  
PAID RECORDED OAKLAND COUNTY REGISTER  
G. WILLIAM CADDELL, CLERK

For corners in  
OAKLAND  
(County)

PONTIAC  
Located in: TWP. Corner Code # A-6

1. Public Land Survey

T 3N R 10E A-6  
T R  
T R SURVEY &  
T R REESTABLISHMENT

2. Property Controlling in Section

S T R  
S T R  
S T R  
S T R

3. Miscellaneous Property in Sec.

SECTION

4. Lot No. \_\_\_\_\_, Recorded Plat \_\_\_\_\_  
5. Private Claims \_\_\_\_\_

RAYMOND J. McCOY

March 28 99

I, \_\_\_\_\_, in a field survey on \_\_\_\_\_, 19\_\_\_\_ do hereby state that under requirements of P.A. 74, Michigan P.A. of 1970, the corner points mentioned in lines 1 and 2 above were in conformance with regulations and rules therefore as required in the current manual of survey instructions of the United States Department of the Interior, Bureau of Land Management or by a decree of a Court of Law and/or that the corner points mentioned in lines 3, 4 and 5 above were in conformance with the rules of the Michigan Board of Land Surveyors or by a Decree of a Court of Law; established, re-established, monumented, recovered, found as expressed below:

NOTE: Not more than 2 corners, all in the same town and range, may be recorded on this certificate.

A. Description of original monument and accessories and/or subsequent restoration:

WAMPLER, D.S., SET POST

THERE ARE NO LCRC'S RECORDED FOR A-6, PONTIAC TWP.

B. Description of corner evidence found and/or method applied in restoring or reestablishing corner:

Found a concrete monument with a 2" diameter brass disk cap stamped Oakland County Remonumentation P.S. #31606 which represents peer approved M-6, WATERFORD TOWNSHIP. The corner represents the SE corner of "OAKWOOD MANOR" (L. 39, Pg. 28, 1925). Corner was validated by measuring closely to the 1926 State Hospital Survey to A-7. It would appear that M-6(WATERFORD) should have been located 14.00 feet of A-6 according to the 1926 Survey and County Survey Records.

State Plane Coordinates N 427793.7255  
13402858.7159

C. Description of monument for corner and accessories established to perpetuate locating the position of the corner:

Replaced the existing brass disk with a 2" diameter brass disk stamped Oakland County Remonumentation P.S. #21270 on the existing concrete monument

Witnesses:


East, 13.46, found chiseled "x" on WestRim Sanitary Manhole  
N 10° E, 34.92, Set OCRT #21270 in West face of 6" poplar  
N 65° W, 38.06, Set OCRT #21270 in South face of 8" pine  
West, 46.85, Set OCRT #21270 in North face of 6" poplar

THE SELECTED LOCATION IS ACCEPTED BY ME AND IS GENERALLY ACCEPTED BY PROFESSIONAL SURVEYORS AS THE BEST AVAILABLE EVIDENCE OF THE POSITION OF THE ORIGINAL CORNER.

Signed by

Surveyor's Michigan License No. 21270

Date May 28, 1999

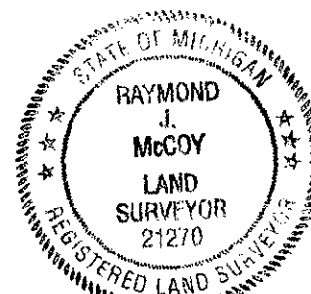

	A	B	C	D	E	F	G	H	I	J	K	L	M
1													
2	6		5		4		3		2				
3													
4	7		8		9		10		11		12		
5													
6	18		17		16		15		14		13		
7													
8	19		20		21		22		23		24		
9													
10	30		29		28		27		26		25		
11													
12	31		32		33		34		35		36		
13													