

31101

LAND CORNER RECORDATION CERTIFICATE

Filing Requirement of Act 74, Mich. P.A. 1970

LIBER 21052 PAGE 153
\$7.00 MISC RECORDING
\$2.00 REMONUMENTATION
02/01/2000 09:59:01 A.M. RECEIPT# 7944
PAID RECORDED - OAKLAND COUNTY
G. WILLIAM CADDELL, CLERK/REGISTER OF DEEDS

For corners in

Oakland

(County)

Located In: Pontiac Corner Code #

1. Public Land Survey

T 3N R 10E A-8

T R

T R

T R

S T R

S T R

S T R

S T R

SECTION

Complies with
ACT 74, P.A. 1970
APPROVED ON: 11-24-99 JIL
OAKLAND COUNTY REMONUMENTATION
FEEB GROUP COMMITTEE
Register of Deeds Stamp & File Number

4. Lot No. , Recorded Plat

5. Private Claims

Raymond J. McCoy

Nov. 15 99


I, Raymond J. McCoy, in a field survey on Nov. 15 99, do hereby state that under requirements of P.A. 74, Michigan P.A. of 1970, the corner points mentioned in lines 1 and 2 above were in conformance with regulations and rules therefore as required in the current manual of survey instructions of the United States Department of the Interior, Bureau of Land Management or by a decree of a Court of Law and/or that the corner points mentioned in lines 3, 4 and 5 above were in conformance with the rules of the Michigan Board of Land Surveyors or by a Decree of a Court of Law; established, re-established, monumented, recovered, found as expressed below:

NOTE: Not more than 2 corners, all in the same town and range, may be recorded on this certificate.

1	A	B	C	D	E	F	G	H	I	J	K	L
2		6		5		4		3		2		1
3												
4		7		8		9		10		11		12
5												
6		18		17		16		15		14		13
7												
8		19		20		21		22		23		24
9												
10		30		29		28		27		26		25
11												
12		31		32		33		34		35		36
13												

A. Description of original monument and accessories and/or subsequent restoration:

NOT AN ORIGINAL GLO CORNER
There are No LCRC's recorded.

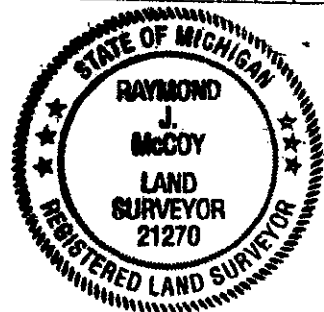

B. Description of corner evidence found and/or method applied in restoring or reestablishing corner:

No corner was found. Corner was established by using the distance shown in the 1926 Survey of the State Hospital Property, being 7.14 feet North of M-8, Waterford and on line between M-8 Waterford and A-7 Pontiac. Corner was validated by fitting very closely to the distance North to A-7 as shown on said 1926 Survey.

State Plane Coordinates N 422483.4314
E 13403098.7123

C. Description of monument for corner and accessories established to perpetuate locating the position of the corner:

Set a 5/8"x24" iron rod with 2" diameter brass disk stamped Oakland County Remonumentation P.S. #21270 in a New monument Box.

Witnesses:

- N 35° W, 48.92' Found Masonary Nail in S. side of Light Pole Base
 - N 70° E, 117.38 Found Masonary Nail S. side of Lightpole Base
 - S 40° E, 109.52' Found Masonary Nail N. side of Top of Lightpole Base
 - S 50° W, 137.13' Found Masonary Nail in N. side of Top of Lightpole Base
- THE SELECTED LOCATION IS ACCEPTED BY ME AND IS GENERALLY ACCEPTED BY PROFESSIONAL SURVEYORS AS THE BEST AVAILABLE EVIDENCE OF THE POSITION OF THE ORIGINAL CORNER.

Signed by Raymond J. McCoy
Surveyor's Michigan License No. 21270

Date Dec 29 1999