

LAND CORNER RECORDATION CERTIFICATE 31103
 Filing Requirement of Act 74, Mich. P.A. 1970

For corners in
Oakland
 (County)

Located in: Pontiac Corner Code #

LIBER 21052 PAGE 155
 \$7.00 MISC RECORDING
 \$2.00 REMONUMENTATION
 02/01/2000 09:59:02 A.M. RECEIPT# 7544
 PAID RECORDED - OAKLAND COUNTY
 G. WILLIAM CADDELL, CLERK/REGISTER OF DEEDS

Compliance with
 ACT 365, P.A. 1990

APPROVED ON: 11-24-99 JIL
 OAKLAND COUNTY REMONUMENTATION
 PEAK GROUP COMMITTEE
 Register of Deeds Stamp & File Number

- 1. Public Land Survey T3N R10E A-10
- 2. Property Controlling in Section S T R SURVEY & RE-ESTABLISHMENT
- 3. Miscellaneous Property in Sec. S T R MAR 21 2000

4. Lot No. _____, Recorded Plat _____
 5. Private Claims _____ SECTION


Raymond J. McCoy Nov. 15 99
 I, _____, in a field survey on _____, 19____ do hereby state that under requirements of P.A. 74, Michigan P.A. of 1970, the corner points mentioned in lines 1 and 2 above were in conformance with regulations and rules therefore as required in the current manual of survey instructions of the United States Department of the Interior, Bureau of Land Management or by a decree of a Court of Law and /or that the corner points mentioned in lines 3, 4 and 5 above were in conformance with the rules of the Michigan Board of Land Surveyors or by a Decree of a Court of Law; established, re-established, monumented, recovered, found as expressed below:

NOTE: Not more than 2 corners, all in the same town and range, may be recorded on this certificate.

	A	B	C	D	E	F	G	H	I	J	K	L
1												
2	6		5		4		3		2			
3												
4	7		8		9		10		11		12	
5												
6	18		17		16		15		14		13	
7												
8	19		20		21		22		23		24	
9												
10	30		29		28		27		26		25	
11												
12	31		32		33		34		35		36	
13												

A. Description of original monument and accessories and/or subsequent restoration:

NOT AN ORIGINAL GLO CORNER
 THERE ARE NO LCRC'S RECORDED.

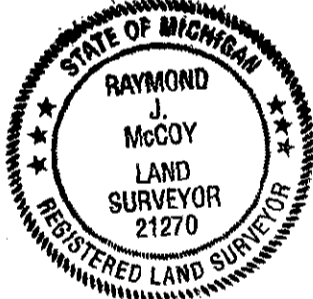

B. Description of corner evidence found and/or method applied in restoring or reestablishing corner:

No corner was found. Corner was established by using the distance shown in the 1926 Survey of the State Hospital being 113 links North of M-10 Waterford on line between M-10 & M-9.

State Plane Coordinates N 417232.7405
 E 13403365.9455

C. Description of monument for corner and accessories established to perpetuate locating the position of the corner:
 Set 5/8"x24" iron rod with 2" diameter brass disk stamped Oakland County Remonumentation P.S. #21270 in a New Monument Box.

Witnesses:
 S 75° E, 47.02 Top of SW bolt of Traffic Support Pole
 S 23° E, 156.98' Top of NW bolt of Traffic support pole
 S 20° W, 122.51 Found OCRT #24598 in S. face of Guy Pole
 N 50° W, 84.28 Set OCRT in E. face of Guy Pole
 THE SELECTED LOCATION IS ACCPETED BY ME AND IS GENERALLY ACCEPTED BY PROFESSIONAL SURVEYORS AS THE BEST AVAILABLE EVIDENCE OF THE POSITION OF THE ORIGINAL CORNER.

Signed by Raymond J. McCoy
 Surveyor's Michigan License No. 21270

Date Dec. 28, 99