

LAND CORNER RECORDATION CERTIFICATE  
Filing Requirement of Act 74, Mich. P.A. 1970

For corners in  
Oakland  
(County)

Located in: Pontiac Twp. Corner Code #

31104

LIBER 21052 PAGE 156  
\$7.00 MISC RECORDING  
\$2.00 REMONUMENTATION  
02/01/2000 09:59:02 A.M. RECEIPT# 7944  
PAID RECORDED - OAKLAND COUNTY  
G. WILLIAM CADDELL, CLERK/REGISTER OF DEEDS  
Compliance with  
ACT 345, P.A. 1990  
11-24-99 JH  
APPROVED ON:  
OAKLAND COUNTY REMONUMENTATION  
PEER GROUP COMMITTEE  
Register of Deeds Stamp & File Number

1. Public Land Survey

T 3NR 10E A-11  
T R SURVEY &  
T R RE-MONUMENTATION  
T R  
S T R  
S T R MAR 21 2000  
S T R  
S T R SECTION

2. Property Controlling  
in Section

3. Miscellaneous  
Property in Sec.

4. Lot No. \_\_\_\_\_, Recorded Plat \_\_\_\_\_  
5. Private Claims \_\_\_\_\_

Raymond J. McCoy Nov. 23 99


I, \_\_\_\_\_, in a field survey on \_\_\_\_\_, 19\_\_\_\_ do hereby state that under requirements of P.A. 74, Michigan P.A. of 1970, the corner points mentioned in lines 1 and 2 above were in conformance with regulations and rules therefore as required in the current manual of survey instructions of the United States Department of the Interior, Bureau of Land Management or by a decree of a Court of Law and/or that the corner points mentioned in lines 3, 4 and 5 above were in conformance with the rules of the Michigan Board of Land Surveyors or by a Decree of a Court of Law; established, re-established, monumented, recovered, found as expressed below:

NOTE: Not more than 2 corners, all in the same town and range, may be recorded on this certificate.

	A	B	C	D	E	F	G	H	I	J	K	L
1												
2	6		5		4		3		2		1	
3												
4	7		6		9		10		11		12	
5												
6	18		17		16		15		14		13	
7												
8	19		20		21		22		23		24	
9												
10	30		29		28		27		26		25	
11												
12	31		32		33		34		35		36	
13												

A. Description of original monument and accessories and/or subsequent restoration:

1817 Post GLO  
There are No LCRC's recorded.

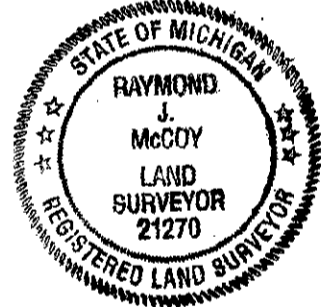

B. Description of corner evidence found and/or method applied in restoring or reestablishing corner:  
No corner was found. Corner was established by extending the South line of "HURON PARK ADD." and intersecting the Township line.

State Plane Coordinates N 414730.8108  
E 13403486.4908

C. Description of monument for corner and accessories established to perpetuate locating the position of the corner:  
Set a 5/8"x24" iron rod with a 2" diameter brass disk stamped Oakland County Remonumentation P.S. #21270 in a New Monument Box.

Witnesses:  
S 47° W, 114.85' to SE corner of Brick Bldg.  
N 40° W, 91.46' 179.01' Top center of Hydrant  
S 18° E, 179.01' Top center of Hydrant  
S 68° E, 60.68' NW corner of conc. Lighpole Base

THE SELECTED LOCATION IS ACCPETED BY ME AND IS GENERALLY ACCEPTED BY PROFESSIONAL SURVEYORS AS THE BEST AVAILABLE EVIDENCE OF THE POSITION OF THE ORIGINAL CORNER.

Signed by Raymond J. McCoy  
Surveyor's Michigan License No. 21270

Date Dec 28 99