

LAND CORNER RECORDATION CERTIFICATE  
Filing Requirement of Act 74, Mich. P.A. 1970

206165

For corners in

OAKLAND  
(County)

PONTIAC

Located in: TWP. Corner Code # B-9

LIBER 20101 PAGE 725  
\$7.00 MISC RECORDING  
\$2.00 REMONUMENTATION  
06/10/1999 12:32:43 P.M. RECEIPT# 41597  
PAID RECORDED - OAKLAND COUNTY  
G. WILLIAM CADDELL, CLERK/REGISTER OF DEEDS

Compliance with  
ACT 345, P.A. 1990

APPROVED ON: 4-4-99 JS  
OAKLAND COUNTY REMONUMENTATION  
PEER GROUP COMMITTEE

Register of Deeds Stamp & File Number

1. Public Land Survey

T3N R10E B-9

T\_\_\_ R\_\_\_  
T\_\_\_ R\_\_\_ SURVEY &  
T\_\_\_ R\_\_\_ RE-MONUMENTATION

2. Property Controlling  
in Section

S\_\_\_ T\_\_\_ R\_\_\_  
S\_\_\_ T\_\_\_ R\_\_\_

3. Miscellaneous  
Property in Sec.

S\_\_\_ T\_\_\_ R\_\_\_  
S\_\_\_ T\_\_\_ R\_\_\_

MAR 21 2000

SECTION

4. Lot No. \_\_\_\_\_, Recorded Plat \_\_\_\_\_

5. Private Claims \_\_\_\_\_

RAYMOND J. McCOY

April 2 99


I, \_\_\_\_\_, in a field survey on \_\_\_\_\_, 19\_\_\_\_ do hereby state that under requirements of P.A. 74, Michigan P.A. of 1970, the corner points mentioned in lines 1 and 2 above were in conformance with regulations and rules therefore as required in the current manual of survey instructions of the United States Department of the Interior, Bureau of Land Management or by a decree of a Court of Law and/or that the corner points mentioned in lines 3, 4 and 5 above were in conformance with the rules of the Michigan Board of Land Surveyors or by a Decree of a Court of Law; established, re-established, monumented, recovered, found as expressed below:

NOTE: Not more than 2 corners, all in the same town and range, may be recorded on this certificate.

	A	B	C	D	E	F	G	H	I	J	K	L	M
1													
2	6		5		4		3		2		1		
3													
4	7		8		9		10		11		12		
5													
6	18		17		16		15		14		13		
7													
8	19		20		21		22		23		24		
9													
10	30		29		28		27		26		25		
11													
12	31		32		33		34		35		36		
13													

A. Description of original monument and accessories and/or subsequent restoration:

WAMPLER, D.S., SET POST  
THERE ARE NO LCRC'S RECORDED.

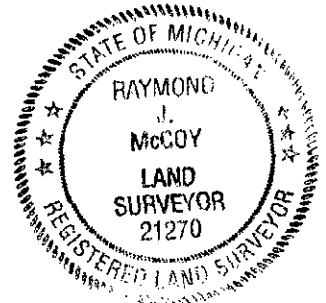

B. Description of corner evidence found and/or method applied in restoring or reestablishing corner:

Found a 1/2" iron pipe with plastic cap #25828. A 1" pipe 48" long lay next to the recovered corner. This corner is currently being surveyed by the State of Michigan (Beaver #25828). The corner was validated by remaining witnesses from a previous survey of the State Hospital property from 1926.

State Plane Coordinates N 419892.8740  
E 13405179.4244

C. Description of monument for corner and accessories established to perpetuate locating the position of the corner:

Replaced the found 1/2" pipe with a concrete monument consisting of a 1/2" rod encased in a concrete cylinder 36" long with a 2" diameter brass disk stamped Oakland County Remonumentation P.S. #21270.

Witnesses:  
N 45° E, 172.36, Set OCRT #21270 in South face of 8" Hickory  
N 65° E, 117.33, Set OCRT #21270 in South face of 16" Hickory  
S 6° W, 183.94, Set OCRT #21270 in West face of 16" Pine  
N 50° W, 232.68, Set OCRT #21270 in NE face of Power Pole.

THE SELECTED LOCATION IS ACCEPTED BY ME AND IS GENERALLY ACCEPTED BY PROFESSIONAL SURVEYORS AS THE BEST AVAILABLE EVIDENCE OF THE POSITION OF THE ORIGINAL CORNER.

Signed by Raymond J. McCoy  
Surveyor's Michigan License No. 21270

Date May 28, 1999