

LAND CORNER RECORDATION CERTIFICATE
Filing Requirement of Act 74, Mich. P.A. 1970 31106

For corners in
Oakland
(County)

Located in: Pontiac Twp. Corner Code #

LIBER 21052 PAGE 158
\$7.00 MISC RECORDING
\$21.00 REMONUMENTATION
02/01/2000 09:59:02 A.M. RECEIPT# 7944
PAID RECORDED - OAKLAND COUNTY
G. WILLIAM CADDELL, CLERK/REGISTER OF DEEDS

1. Public Land Survey

T 3NR10E C-3

T R

T R

T R

2. Property Controlling in Section

S T RECORDATION

S T R

3. Miscellaneous Property in Sec.

S T R MAR 21 2000

S T R

Register of Deeds Stamp & File Num
11-24-99 JJK

SECTION

4. Lot No. _____, Recorded Plat _____
5. Private Claims _____

Raymond J. McCoy

Nov. 30 99


I, _____, in a field survey on _____, 19____ do hereby state that under requirements of P.A. 74, Michigan P.A. of 1970, the corner points mentioned in lines 1 and 2 above were in conformance with regulations and rules therefore as required in the current manual of survey instructions of the United States Department of the Interior, Bureau of Land Management or by a decree of a Court of Law and/or that the corner points mentioned in lines 3, 4 and 5 above were in conformance with the rules of the Michigan Board of Land Surveyors or by a Decree of a Court of Law; established, re-established, monumented, recovered, found as expressed below:

NOTE: Not more than 2 corners, all in the same town and range, may be recorded on this certificate.

A	B	C	D	E	F	G	H	I	J	K
1										
2	6	5	4	3	2					
3										
4	7	8	9	10	11					
5										
6	18	17	16	15	14					
7										
8	19	20	21	22	23					
9										
10	30	29	28	27	26					
11										
12	31	32	33	34	35					
13										

A. Description of original monument and accessories and/or subsequent restoration:

Corner falls in Lake Angeles
There are no LCRC's recorded.

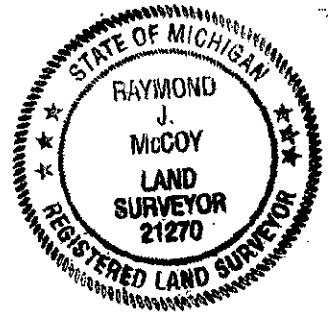

B. Description of corner evidence found and/or method applied in restoring or reestablishing corner:

A meander corner was established by using monumentation found in "SUPERVISOR'S PLAT NO. 14".

State Plane Coordinates N 435956.3544
E13407500.5945

C. Description of monument for corner and accessories established to perpetuate locating the position of the corner:

Set a concrete monument at the MEANDER CORNER position, consisting of a 1/2" rod encased in a 4" diameter concrete cylinder 36" long with a 2" diameter brass disk stamped Oakland County Remoumentation P.S. #21270.

Witnesses:

- N 44° W, 36.42 Set OCRT SW face of Tw. 8" Birch
- N 54° E, 53.25, Set OCRT in NW face of 18" Hickory
- S 9° W, 9.69' Set OCRT in E. face of 24" Maple
- S 80° E, 20.11' Set OCRT in N. face of 7" Pine

THE SELECTED LOCATION IS ACCEPTED BY ME AND IS GENERALLY ACCEPTED BY PROFESSIONAL SURVEYORS AS THE BEST AVAILABLE EVIDENCE OF THE POSITION OF THE ORIGINAL CORNER.

Signed by Raymond J. McCoy
Surveyor's Michigan License No. 21270

Date 1-15-00