

LIBER 19827 PAGE 751
\$7.00 MISC RECORDING
\$2.00 REMONUMENTATION
4/13/1999 01:46:43 P.M. RECEIPT# 1847
PAID RECORDED - OAKLAND COUNTY
G. WILLIAM CADDELL, CLERK/REGISTER OF D

LAND CORNER RECORDATION CERTIFICATE
Filing Requirement of Act 74, Mich. P.A. 1970

For corners in

Oakland
(County)

Located in: Pontiac Twp. Corner Code # C-6

1. Public Land Survey

T 3NR 10E C-6

T

T

T

2. Property Controlling in Section

S T SURVEY & MONUMENTATION

3. Miscellaneous Property in Sec.

S T

S T

S T MAR 21 2000

Compliance with ACT 345, P.A. 1990
APPROVED ON: 3-18-99 JS
OAKLAND COUNTY REMONUMENTATION PEER GROUP COMMITTEE
Register of Deeds Stamp & File Number

SECTION

4. Lot No. , Recorded Plat

5. Private Claims


I, Raymond J. McCoy, in a field survey on Feb. 22, 1999 do hereby state that under requirements of P.A. 74, Michigan P.A. of 1970, the corner points mentioned in lines 1 and 2 above were in conformance with regulations and rules therefore as required in the current manual of survey instructions of the United States Department of the Interior, Bureau of Land Management or by a decree of a Court of Law and /or that the corner points mentioned in lines 3, 4 and 5 above were in conformance with the rules of the Michigan Board of Land Surveyors or by a Decree of a Court of Law; established, re-established, monumented, recovered, found as expressed below.

NOTE: Not more than 2 corners, all in the same town and range, may be recorded on this certificate.

A	B	C	D	E	F	G	H	I	J	K
1										
2	6		5		4		3		2	
3										
4	7		8		9		10		11	
5										
6	18		17		16		15		14	
7										
8	19		20		21		22		23	
9										
10	30		29		28		27		26	
11										
12	31		32		33		34		35	
13										

A. Description of original monument and accessories and/or subsequent restoration:

Wampler, D.S. Set Post
There are No recorded L.C.R.C.'s recorded.

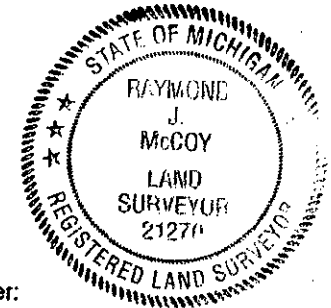

B. Description of corner evidence found and/or method applied in restoring or reestablishing corner:

Found a P.K. Nail in the intersection of Stanley & Columbia Rds.
Reset corner 0.49' South of the found P.K. Nail using Monumentation in both "WALTON BLVD. SUBDIVISION"(L.47, Pg. 37, 1927) and "ASSESSOR'S PLAT NO. 144" (L. 5, Pg. 57, 1939).

State Plane Coordinates N 428222.3979
E 13407419.9256

C. Description of monument for corner and accessories established to perpetuate locating the position of the corner:

Set a 5/8"x24" iron rod with 2" diameter brass disk stamped Oakland County Remonumentation P.S. #21270 in a New Monument Box.

Witnesses:

N 20° E, 133.04' Set O.C.R.T. #21270 W. face of 20" ELM

N 12° W, 132.16' Set O.C.R.T. #21270 E. face of Power Pole.

S 34° W, 49.82' Set O.C.R.T. #21270 E. face of Power Pole.

S 15° E, 159.04' Set O.C.R.T. #21270 W. face of Power Pole.

THE SELECTED LOCATION IS ACCEPTED BY ME AND IS GENERALLY ACCEPTED BY PROFESSIONAL SURVEYORS AS THE BEST AVAILABLE EVIDENCE OF THE POSITION OF THE ORIGINAL CORNER.

Signed by Raymond J. McCoy
Surveyor's Michigan License No. 21270

Date Mar 22 1999