

LAND CORNER RECORDATION CERTIFICATE  
Filing Requirement of Act 74, Mich. P.A. 1970

For corners in

Oakland

(County)

Located In:

Pontiac

Twp - Corner Code #

31107

1. Public Land Survey T3N R 10E D-11  
 T \_\_\_ R \_\_\_  
 T \_\_\_ R \_\_\_  
 T \_\_\_ R \_\_\_  
 T \_\_\_ R \_\_\_  
 2. Property Controlling in Section S \_\_\_ T \_\_\_ R \_\_\_  
 S \_\_\_ T \_\_\_ R \_\_\_  
 3. Miscellaneous Property in Sec. S \_\_\_ T \_\_\_ R \_\_\_  
 S \_\_\_ T \_\_\_ R \_\_\_

LIBER 21052 PAGE 159  
 \$7.00 MISC RECORDING  
 \$2.00 REMONUMENTATION  
 02/01/2000 09:59:02 A.M. RECEIPT# 7944  
 PAID RECORDED OAKLAND COUNTY  
 G WILLIAM CADDELL, CLERK/REGISTER OF DEEDS

APPROVED ON 7-7-99 JK  
 OAKLAND COUNTY REGISTER OF DEEDS  
 2000 0001 0000 0000

Register of Deeds Stamp & File Number

4. Lot No. \_\_\_\_\_, Recorded Plat \_\_\_\_\_  
 5. Private Claims \_\_\_\_\_

Raymond J. McCoy June 25 99

I, \_\_\_\_\_, in a field survey on \_\_\_\_\_, 19\_\_\_\_ do hereby state that under requirements of P.A. 74, Michigan P.A. of 1970, the corner points mentioned in lines 1 and 2 above were in conformance with regulations and rules therefore as required in the current manual of survey instructions of the United States Department of the Interior, Bureau of Land Management or by a decree of a Court of Law and/or that the corner points mentioned in lines 3, 4 and 5 above were in conformance with the rules of the Michigan Board of Land Surveyors or by a Decree of a Court of Law; established, re-established, monumented, recovered, found as expressed below:

NOTE: Not more than 2 corners, all in the same town and range, may be recorded on this certificate.

	A	B	C	D	E	F	G	H	I	J	K	L	M
1													
2	6		5		4		3		2		1		
3													
4	7		8		9		10		11		12		
5													
6	18		17		16		15		14		13		
7													
8	19		20		21		22		23		24		
9													
10	30		29		28		27		26		25		
11													
12	31		32		33		34		35		36		
13													

A. Description of original monument and accessories and/or subsequent restoration:

1817 Post, GLO  
 There is one LCRC recorded.  
 1) 1997-Wilkerson, L. 17355, Pg. 880, Set P.K. nail from A/P #115, 1 witnesses

B. Description of corner evidence found and/or method applied in restoring or reestablishing corner:

No corner was found. Corner was re-established by using monumentation found in "ELKS PARK PLAT" which has been subsequently replatted into "ASSESSOR'S PLAT NO. 115", more particularly holding to the recorded bearing and distance tie to the section corner as recited in said ELKS PARK PLAT from the found monumentation along Pike, Williams and Exchange Streets. Corner location fits close to the remaining witness tie in the above LCRC(45.36v.44.78(m)).

State Plane Coordinate N 415061.1352  
 E 13410691.9758


C. Description of monument for corner and accessories established to perpetuate locating the position of the corner:

Set a 5/8"x24" iron rod with a 2" diameter brass disk stamped  
 County Remonumentation P.S. #21270 in a new monument box.

Witnesses:

N 47° E, 44.63' Set chiseled "x" on Top/hydrant  
 N 5° E, 132.66' Set OCRT in W. face of Power Pole  
 N 46° W, 44.78', SE corner of Brick Bldg. #210  
 S 42° W, 11.45' Set chiseled "x" on N. rim of AMT. M.H.

THE SELCTED LOCATION IS ACCEPTED BY ME AND IS GENERALLY ACCEPTED  
 PROFESSIONAL SURVEYORS AS THE BEST AVIALABLE EVIDENCE OF THE POSITION OF  
 THE ORIGINAL CORNER.

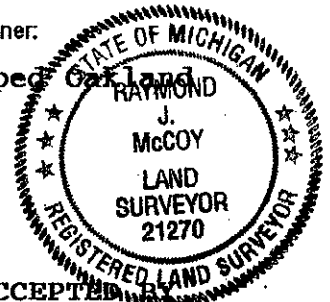

Signed by Raymond J. McCoy  
 Surveyor's Michigan License No. 21270

Date 1-5-00