LIBER 19827 PAGE 754

126757

LIBER 19827 PAGE 754
$7.00 MISC RECORDING
$2.00 REMONUMENTATION
04/13/1999 01:46:43 P.M. RECEIPT# 18
PAID RECORDED - OAKLAND COUNTY
G. WILLIAM CADDELL, CLERK/REGISTER OF

LAND CORNER RECORDATION CERTIFICATE
Filing Requirement of Act 74, Mich. P.A. 1970

For corners in Oakland (County) Located in: Pontiac Twp. Corner Code #

1. Public Land Survey T3N R 10E E-4
T___ R___
T___ R___
T___ R___

2. Property Controlling S___ T___ R___
in Section S___ T___ R___
3. Miscellaneous S___ T___ R___
Property in Sec. S___ T___ R___

SURVEY & RE[illegible]TATION
MAR 31 2000
SECTION

Compliance with ACT 345, P.A. 1990
APPROVED ON: 3-18-99 JS
OAKLAND COUNTY REMONUMENTATION PEER GROUP COMMITTEE
Register of Deeds Stamp & File Number

4. Lot No. _____, Recorded Plat _____
5. Private Claims _____

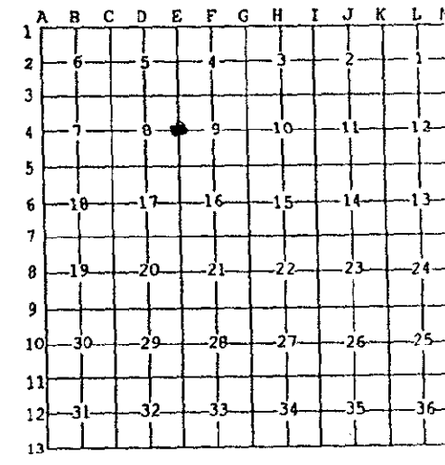

I, Raymond J.McCoy in a field survey on Feb. 18, 19 99 do hereby state that under requirements of P.A. 74, Michigan P.A. of 1970, the corner points mentioned in lines 1 and 2 above were in conformance with regulations and rules therefore as required in the current manual of survey instructions of the United States Department of the Interior, Bureau of Land Management or by a decree of a Court of Law and /or that the corner points mentioned in lines 3, 4 and 5 above were in conformance with the rules of the Michigan Board of Land Surveyors or by a Decree of a Court of Law; established, re-established, monumented, recovered, found as expressed below:

NOTE: Not more than 2 corners, all in the same town and range, may be recorded on this certificate.

A. Description of original monument and accessories and/or subsequent restoration:

Wampler, D.S., Set Post
2 L.C.R.C.
*1) 1977- D. Pawlaczyk, No description of monument given
*2) 1995- D. King, Found P.K. Nail in Pavement.

STATE OF MICHIGAN
RAYMOND J. McCOY
LAND SURVEYOR
21270
REGISTERED LAND SURVEYOR

B. Description of corner evidence found and/or method applied in restoring or reestablishing corner:

Found 3/8" diameter P.K. Nail in Pavement(Asphalt) in E. Highwood Dr., 40 Ft. East of centerline of W. Highwood Dr. & 28 Ft. South of centerline of E. Highwood.
Validated corner with irons in unrecorded "HIGHWOOD INDUSTRIAL PARK" and with witnesses in above L.C.R.C.

State Plane Coordinates N 433759.8174
E 13412502.7460

C. Description of monument for corner and accessories established to perpetuate locating the position of the corner:

Replaced found P.K. Nail with a 5/8"x24" iron rod with 2" diameter brass disk stamped Oakland County Remonumentation P.S. #21270 in a New Monument Box.
Witnesses:
N 50° E, 57.96' Set O.C.R.T. #21270 South face 28" Oak
S 70° E, 96.77' Set O.C.R.T. #21270 in North face 32" Oak
S 45° E, 41.38' Set O.C.R.T. #21270 North face of 6" Maple
S 70° W, 123.19' Set O.C.R.T. #21270 South face 6" Maple

THE SELECTED LOCATION IS ACCEPTED BY ME AND IS GENERALLY ACCEPTED BY PROFESSIONAL SURVEYORS AS THE BEST AVAILABLE EVIDENCE OF THE POSITION OF THE ORIGINAL CORNER.

Signed by Raymond J. McCoy Date May 22 1999
Surveyor's Michigan License No. 21270

FORM APPROVED BY MICHIGAN STATE BOARD OF PROFESSIONAL SURVEYORS, JAN. 28, 1971
REVISED MAY 14,1975
REVISED JAN., 1963
REVISED OCT., 1995