

LAND CORNER RECORDATION CERTIFICATE  
Filing Requirement of Act 74, Mich. P.A. 1970

For corners in

OAKLAND

(County)

Located in: **PONTIAC** TWP. Corner Code # **E-8**

1. Public Land Survey

T 3NR 10E E-8

T \_\_\_ R \_\_\_

T \_\_\_ R \_\_\_ SURVEY & REMONUMENTATION

2. Property Controlling in Section

S \_\_\_ T \_\_\_ R \_\_\_

S \_\_\_ T \_\_\_ R \_\_\_

MAR 21 2000

3. Miscellaneous Property in Sec.

S \_\_\_ T \_\_\_ R \_\_\_

S \_\_\_ T \_\_\_ R \_\_\_

SECTION

206152

LIBER 20101 PAGE 712  
\$7.00 MISC RECORDING  
\$2.00 REMONUMENTATION  
06/10/1999 12:32:43 P.M. RECEIPT# 41597  
PAID RECORDED - OAKLAND COUNTY  
G. WILLIAM CADDY CLERK/REGISTER OF DEEDS  
ACT 345, P.A. 1990

APPROVED ON: 4-27-99 JS  
OAKLAND COUNTY REMONUMENTATION  
PEER GROUP COMMITTEE

Register of Deeds Stamp & File Number

4. Lot No. \_\_\_\_\_, Recorded Plat \_\_\_\_\_

5. Private Claims \_\_\_\_\_

**RAYMOND J. McCOY**

**April 23 99**


I, \_\_\_\_\_, in a field survey on \_\_\_\_\_, 19\_\_\_\_ do hereby state that under requirements of P.A. 74, Michigan P.A. of 1970, the corner points mentioned in lines 1 and 2 above were in conformance with regulations and rules therefore as required in the current manual of survey instructions of the United States Department of the Interior, Bureau of Land Management or by a decree of a Court of Law and /or that the corner points mentioned in lines 3, 4 and 5 above were in conformance with the rules of the Michigan Board of Land Surveyors or by a Decree of a Court of Law, established, re-established, monumented, recovered, found as expressed below:

NOTE: Not more than 2 corners, all in the same town and range, may be recorded on this certificate.

	A	B	C	D	E	F	G	H	I	J	K	L
1												
2		6		5		4		3		2		1
3												
4		7		8		9		10		11		12
5												
6		18		17		16		15		14		13
7												
8		19		20		21		22		23		24
9												
10		30		29		28		27		26		25
11												
12		31		32		33		34		35		36
13												

A. Description of original monument and accessories and/or subsequent restoration:

**WAMPLER, D.S., SET POST  
THERE ARE NO LCRC'S RECORDED.**

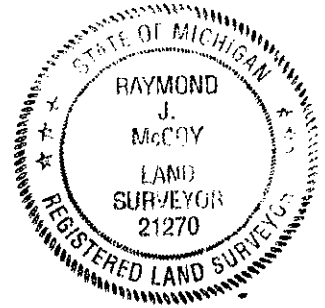

B. Description of corner evidence found and/or method applied in restoring or reestablishing corner:

No corner was found. Corner was established by using monumentation in "MODERN HOUSING CORPORATION ADDITION"(L. 20, Pg. 22, 1919) and "ASSESSOR'S PLAT NO. 11" (L. 1A, Pg. 11, 1925), more particularly the found monuments located along the Easterly R/W line of Edison St. The corner was set by measuring the recorded angles and distances from the found monuments back to the corner.

State Plane Coordinates N 423087.8318  
E 13413072.9925

C. Description of monument for corner and accessories established to perpetuate locating the position of the corner:

Set a concrete monument consisting of a 1/2" iron rod encased in a 4" diameter concrete cylinder 36" long with a 2" diameter brass disk stamped Oakland County Remonumentation P.S. #21270.

Witnesses:

S 75° W, 59.57, Set OCRT #21270 in North face of 10" Pine

N 60° W, 69.78, Set OCRT #21270 in NE face of 8" Maple

N 50° E, 65.58, Set OCRT #21270 in North face 8" Cherry

S 80° E, 58.98, Northwest corner of DE Utility Bldg. foundation

THE SELECTED LOCATION IS ACCPETED BY ME AN DIS GENERALLY ACCEPTED BY PROFESSIONAL SURVEYORS AS THE BEST AVILABLE EVIDENCE OF THE POSITION OF THE ORIGINAL CORNER.

Signed by Raymond J. McCoy

Date May 28, 1999

Surveyor's Michigan License No. 21270