

LAND CORNER RECORDATION CERTIFICATE

Filing Requirement of Act 74, Mich. P.A. 1970

For corners in Oakland

(County)

Pontiac Located in: Twp. Corner Code #

LIBER 21052 PAGE 161 \$2.00 REMONUMENTATION 02/01/2000 09:59:02 A.M. RECEIPT# 7944 PAID RECORDED - OAKLAND COUNTY G. WILLIAM CADDELL, CLERK/REGISTER OF DEEDS

1. Public Land Survey

T 3N R 10E E-11

T R

T R

T R

2. Property Controlling in Section

S T R

S T R

3. Miscellaneous Property in Sec.

S T R

S T R

STAMPED: SURVEY & REMONUMENTATION MAR 21 2000

Conform with ACT 355, P.A. 1990

PROVED ON: 9-15-99 JH LAND COUNTY REMONUMENTATION PLAN GROUP COMMITTEE

Register of Deeds Stamp & File Number

SECTION

4. Lot No. , Recorded Plat 5. Private Claims

September 4 99

I, Raymond J. McCoy, in a field survey on 19 do hereby state that under requirements of P.A. 74, Michigan P.A. of 1970, the corner points mentioned in lines 1 and 2 above were in conformance with regulations and rules therefore as required in the current manual of survey instructions of the United States Department of the Interior, Bureau of Land Management or by a decree of a Court of Law and/or that the corner points mentioned in lines 3, 4 and 5 above were in conformance with the rules of the Michigan Board of Land Surveyors or by a Decree of a Court of Law; established, re-established, monumented, recovered, found as expressed below:

NOTE: Not more than 2 corners, all in the same town and range, may be recorded on this certificate.


Grid table with columns A-K and rows 1-13. A dot is marked at row 11, column E.

A. Description of original monument and accessories and/or subsequent restoration:

1817 Post, GLO

There is one LCRC recorded.

1) 1997-Wilkerson, L.17355, Pg. 881, Witness to cut cross

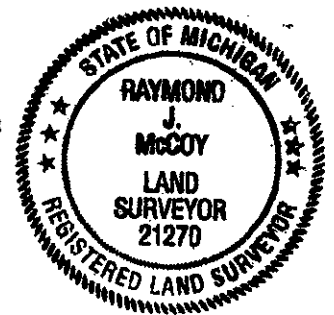

B. Description of corner evidence found and/or method applied in restoring or reestablishing corner:

Found cut cross in centerline of the Southerly Eastbound Lane of Auburn Ave. 40 ft. west of the centerline of Northbound Wide Track Drive. This corner was not accepted. Corner was established by using found monumentation in "assessor'S PLAT NO. 133"(being a re-plat of Eastern Addition) by offsetting the Right-Of-Way distance from the found irons along the Southerly line of Auburn Avenue and holding the recorded distance back to the re-established corner. The corner falls 22.80 feet west of the found cut cross. The above LCRC states this corner was established by using Assessor's Plat No. 88, However, This plat lies 1/2 mile south of the proposed corner and has no mathematical tie to E-11.

State Plane Coordinates N 415195.3404

E 13413380.3950

C. Description of monument for corner and accessories established to perpetuate locating the position of the corner. Set a 5/8"x24" iron rod with a 2" diameter brass disk stamped Oakland County Remonumentation P.S. #21270 in a New Monument Box.

Witnesses:

S 19° E, 36.84', Set cut "x" in NE base of Metal Traffic Support Pole

S 87° W, 55.01', Set cut "x" on NE bolt of Lightpole

N 35° W, 90.64', set cut "x" on SE bolt of Lightpole

N 14° E, 73.65' Set cut "x" Easterly base of Metal Traffic Support Pole.

THE SELECTED LOCATION IS ACCEPTED BY ME AND IS GENERALLY ACCEPTED BY PROFESSIONAL SURVEYORS AS THE BEST AVAILABLE EVIDENCE OF THE POSITION OF THE ORIGINAL CORNER.

Signed by [Signature] Surveyor's Michigan License No. 21270

Date Jan 5, 2000