

LAND CORNER RECORDATION CERTIFICATE  
Filing Requirement of Act 74, Mich. P.A. 1970

For corners in

Oakland  
(County)

Located in: Pontiac Corner Code #  
Twp. \_\_\_\_\_

- |                                    |   |           |   |            |       |
|------------------------------------|---|-----------|---|------------|-------|
| 1. Public Land Survey              | T | <u>3N</u> | R | <u>10E</u> | E-13  |
|                                    | T | _____     | R | _____      | _____ |
|                                    | T | _____     | R | _____      | _____ |
|                                    | T | _____     | R | _____      | _____ |
| 2. Property Controlling in Section | S | _____     | T | _____      | _____ |
|                                    | S | _____     | T | _____      | _____ |
| 3. Miscellaneous Property in Sec.  | S | _____     | T | _____      | _____ |
|                                    | S | _____     | T | _____      | _____ |

71706

\$7.00 MISC RECORDING  
\$2.00 REMONUMENTATION  
03/03/1999 03:32:14 P.M. RECEIPT# 4986  
PAID RECORDED - OAKLAND COUNTY  
G. WILLIAM CADDELL, CLERK/REGISTER OF DEEDS

APPROVED BY: 1-13-99 JS  
OAKLAND COUNTY REMONUMENTATION  
PEER GROUP COMMITTEE

Register of Deeds Stamp & File Number

4. Lot No. \_\_\_\_\_, Recorded Plat \_\_\_\_\_  
5. Private Claims \_\_\_\_\_

SECTION

A	B	C	D	E	F	G	H	I	J	K	L
1											
2	6		5		4		3		2		1
3											
4	7		8		9		10		11		12
5											
6	10		17		16		15		14		13
7											
8	19		20		21		22		23		24
9											
10	30		29		28		27		26		25
11											
12	31		32		33		34		35		36
13											

I, Raymond J. McCoy in a field survey on Dec. 4, 1998 do hereby state that under requirements of P.A. 74, Michigan P.A. of 1970, the corner points mentioned in lines 1 and 2 above were in conformance with regulations and rules therefore as required in the current manual of survey instructions of the United States Department of the Interior, Bureau of Land Management or by a decree of a Court of Law and /or that the corner points mentioned in lines 3, 4 and 5 above were in conformance with the rules of the Michigan Board of Land Surveyors or by a Decree of a Court of Law; established, re-established, monumented, recovered, found as expressed below:

NOTE: Not more than 2 corners, all in the same town and range, may be recorded on this certificate.

A. Description of original monument and accessories and/or subsequent restoration:  
1817 G.L.O. Wampler D.S. Set post

No L.C.R.C.'s were recorded.

B. Description of corner evidence found and/or method applied in restoring or reestablishing corner:  
Set 5/8"x24" iron rod w/2" diameter brass disk stamped Oakland County Remonumentation P.S. #21270 in a new monument box at the intersection of Franklin and South Blvd. Set point by recovered monumentation in "Crystal Lake Sub." Rec. L.16, Pg.17, and in "Wilson Park Sub." Rec. L.20, Pg.29.


State Plane Coordinate N 409764.3499  
E 13413621.6774

C. Description of monument for corner and accessories established to perpetuate locating the position of the corner:  
Set 5/8"x24" iron rod w/2" diameter brass disk stamped Oakland County Remonumentation P.S. #21270 in a new monument box.

- Witnesses:
- S30°E 57.17' Set O.C.R.T. #21270 in NE face of P.P.
  - S30°W 56.71' Set O.C.R.T. #21270 in E face of P.P.
  - N30°W 47.35' Set O.C.R.T. #21270 in NE face of P.P.
  - N45°E 51.11' Set O.C.R.T. #21270 in N face of P.P.

The selected location is accepted by me and is generally accepted by Professional Surveyors as the best available evidence of the position of the original corner.

Signed by Raymond J. McCoy  
Surveyor's Michigan License No. 21270

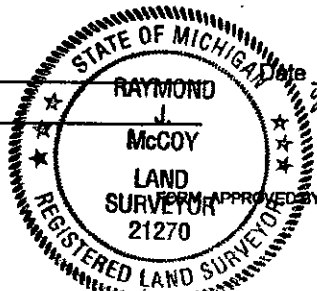

Date Jan. 21, 1999