

LAND CORNER RECORDATION CERTIFICATE
Filing Requirement of Act 74, Mich. P.A. 1970

206140

For corners in

OAKLAND

(County)

PONTIAC

Located In: TWP. Corner Code # F-9

LIBER 20101 PAGE 700
\$7.00 MISC RECORDING
\$2.00 REMONUMENTATION
06/10/1999 12:32:43 P.M. RECEIPT# 41597
PAID RECORDED - OAKLAND COUNTY
G. WILLIAM CADDELL, CLERK/REGISTER OF DEEDS

1. Public Land Survey

T 3N R 10E F-9

T R

T R

T R

2. Property Controlling in Section

S T R

S T R

3. Miscellaneous Property in Sec.

S T R

S T R

SURVEY & RELOCATION
MAR 21 2000
SECTION

Compliance with ACT 345, P.A. 1990

APPROVED ON: 9-27-99 JS
OAKLAND COUNTY REMONUMENTATION PEER GROUP COMMITTEE

Register of Deeds Stamp & File Number

4. Lot No. _____, Recorded Plat _____

5. Private Claims _____

RAYMOND J. McCOY

April 23 99


I, _____, in a field survey on _____, 19____ do hereby state that under requirements of P.A. 74, Michigan P.A. of 1970, the corner points mentioned in lines 1 and 2 above were in conformance with regulations and rules therefore as required in the current manual of survey instructions of the United States Department of the Interior, Bureau of Land Management or by a decree of a Court of Law and /or that the corner points mentioned in lines 3, 4 and 5 above were in conformance with the rules of the Michigan Board of Land Surveyors or by a Decree of a Court of Law; established, re-established, monumented, recovered, found as expressed below:

NOTE: Not more than 2 corners, all in the same town and range, may be recorded on this certificate.

	A	B	C	D	E	F	G	H	I	J	K	L	M
1													
2	6		5		4		3		2			1	
3													
4	7		8		9		10		11			12	
5													
6	18		17		16		15		14			13	
7													
8	19		20		21		22		23			24	
9													
10	30		29		28		27		26			25	
11													
12	31		32		33		34		35			36	
13													

A. Description of original monument and accessories and/or subsequent restoration:

WAMPLER, D.S., SET POST
THERE ARE NO LCRC'S RECORDED.

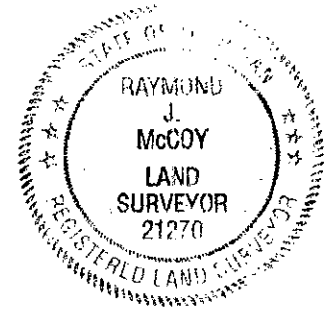

B. Description of corner evidence found and/or method applied in restoring or reestablishing corner:

No corner was found. Corner was established by using monumentation found in "PONTIAC KNOLLS"(L. 87, Pgs. 28-30), more particularly found irons along the Southerly Right-Of-Way lines of Delco & Grand View Drives. Using the rcordeed angles and distances from the monumentation found on the Southerly line Delco Dr. the corner was established and then validated by the monumentation found on Grand View Blvd.

State Plane Coordiantes N 420410.1923
E 13415820.7508

C. Description of monument for corner and accessories established to perpetuate locating the position of the corner:

Set a 5/8"x24" iron rod with 2" diameter brass disk stamped Oakland County Remonumentation P.S. #21270 in a new monument Box.

Witnesses:

South, 14.23, set chiseled "x" on Top/curb

North, 14.32, set chiseled "x" on Top/curb

N 70° E, 107.43, set OCRT #21270 on South face of 20" Maple

S 50° W, 39.09, set OCRT #21270 in South face of 8" Poplar

THE SELECTED LOCATION IS ACCEPTED BY ME IS GENERALLY ACCEPTED BY PROFESSIONAL SURVEYORS AS THE BEST AVAILABLE EVIDENCE OF THE POSITION OF THE ORIGINAL CORNER.

Signed by Raymond J. McCoy
Surveyor's Michigan License No. 21270

Date May 28, 1999