

LAND CORNER RECORDATION CERTIFICATE
Filing Requirement of Act 74, Mich. P.A. 1970

For corners in
Oakland
(County)

Located in: Pontiac TWP - Corner Code #

31110

LIBER 21052 PAGE 162
\$7.00 MISC RECORDING
\$2.00 REMONUMENTATION
02/01/2000 09:59:02 A.M. RECEIPT# 7944
PAID RECORDED - OAKLAND COUNTY
B. WILLIAM CADDELL, CLERK/REGISTER OF DEEDS

Compliate with
ACT 345, P.A. 1990
9-15-99 JIL
REGISTER OF DEEDS
REGISTER OF DEEDS STAMP & FILE NUM

1. Public Land Survey T 3N R 10E F-11
T R
T R
2. Property Controlling S T R
in Section S T R
3. Miscellaneous S T R
Property in Sec. S T R

4. Lot No. _____, Recorded Plat SECTION
5. Private Claims _____

Raymond J. McCoy July 24 99

I, _____, in a field survey on _____, 19____ do hereby state that under requirements of P.A. 74, Michigan P.A. of 1970, the corner points mentioned in lines 1 and 2 above were in conformance with regulations and rules therefore as required in the current manual of survey instructions of the United States Department of the Interior, Bureau of Land Management or by a decree of a Court of Law and/or that the corner points mentioned in lines 3, 4 and 5 above were in conformance with the rules of the Michigan Board of Land Surveyors or by a Decree of a Court of Law; established, re-established, monumented, recovered, found as expressed below:

NOTE: Not more than 2 corners, all in the same town and range, may be recorded on this certificate.

	A	B	C	D	E	F	G	H	I	J	K
1											
2	6		5		4		3		2		
3											
4	7		8		9		10		11		
5											
6	18		17		16		15		14		
7											
8	19		20		21		22		23		
9											
10	30		29		28		27		26		
11											
12	31		32		33		34		35		
13											


A. Description of original monument and accessories and/or subsequent restoration:

1817 Post GLO
There are no LCRC's recorded for this corner.

B. Description of corner evidence found and/or method applied in restoring or reestablishing corner:

Corner was established by using monumentation in "AUBURN GARDENS", from the found monumentation measuring the recorded angle and distance to the corner. Corner was validated by using found monumentation in "ASSESSOR'S PLAT NO. 138".

State Plane Coordinates N 415326.6214
E 13416058.6170

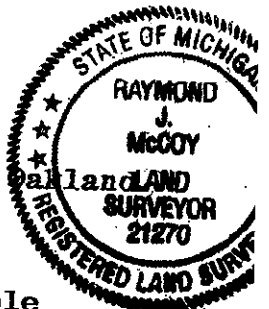

C. Description of monument for corner and accessories established to perpetuate locating the position of the corner:

Set a 5/8"x24" iron rod with a 2" diameter brass disk stamped Oakland County Remonumentation P.S. #21270 in a New Monument Box.
Witnesses:
S 70° W, 171.86', Set chiseled "x" on Top of Hydrant
N 70° W, 88.91', set chiseled "x" on S. face of Metal Light Pole
S 40° E, 41.75, Set chiseled "x" on SE face of Metal Light Pole
S 16° W, 66.34', NE corner of concrete church foundation.

THE SELECTED LOCATION IS ACCEPTED BY ME AND IS GENERALLY ACCEPTED BY PROFESSIONAL SURVEYORS AS THE BEST AVAILABLE EVIDENCE OF THE POSITION OF THE ORIGINAL CORNER

Signed by Raymond J. McCoy
Surveyor's Michigan License No. 21270

Date 1-5-00